Name

Service No.

Address VACANT LOT BTW #36 & #42 CARY AVE

Location

Kind of Pipe PVC

Size 6"

Size of Main 8"

Repair—Renewal—New Service RENEWAL PROJECT 99-12

Location

Date	Material	Amount	Total	Date		Amount
				10-15-1999		
					26' 6" PVC	

DATE 10-15-1999

TOWN OF LEXINGTON — BOARD OF PUBLIC WORKS

SEWER DIVISION

Sketch of Service Here

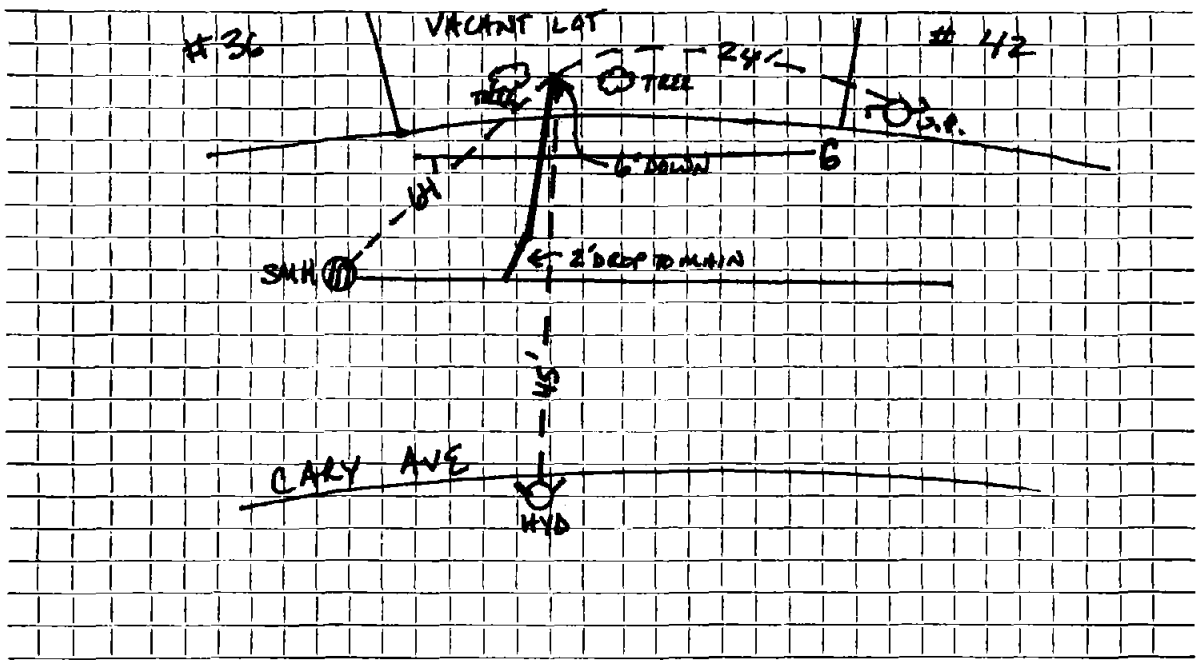

Connection made in ..... Street. Work completed .....

Remarks: 4" GAS MAIN 1.5' DOWN FROM PAVEMENT

GAS MAIN 12' FROM STUB END OF SEWER LATERAL

FIELD BK 99-12-1 PG32

D.F.