**Name** **Service No.**

**Address** 4 CHADBOURNE RD.

**Location**

**Kind of Pipe** PVC **Size** 6" **Size of Main** 8"

**Repair—Renewal—New Service** **Location**

| Date | Material | Amount | Total | Date | | Amount |
|---|---|---|---|---|---|---|
| ~~10-17-80~~ | ~~20' 6" PVC~~ | 14.00 = | $280.00 | | | |
| | | | | 10-17-80 | | |
| | | | | | 20' 6" PVC | |

[redacted]

DATE 11-18-80

TOWN OF LEXINGTON — BOARD OF PUBLIC WORKS

# SEWER DIVISION

Sketch of Service Here 4

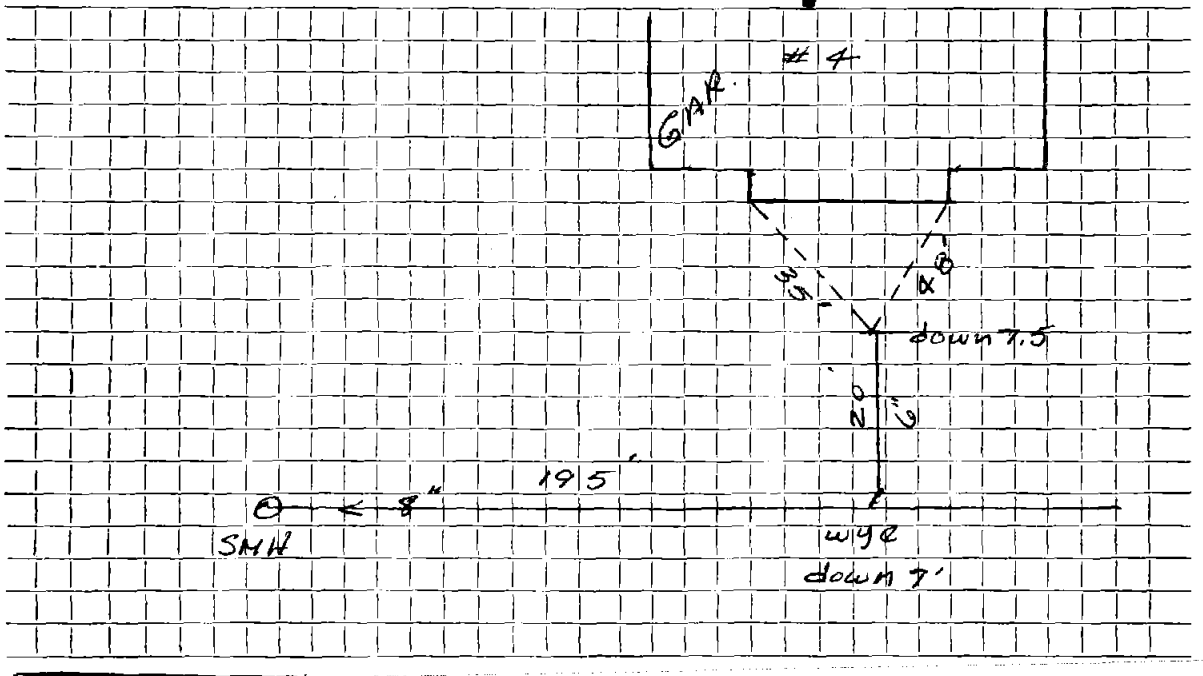


Connection made in [redacted] Street. Work completed .....

CHADBOURNE RD.

Remarks: .....