Name STEVEN REILLY **Service No.**

Address 2 CHERRY STREET

Location

Kind of Pipe P.V.C. **Size** 6" **Size of Main**

Repair **Renewal** **New Service** PERMIT Nº 1009 **Location**

Date		Material	Amount		Total		Date			Amount	
SEPT 18	97	48' - 6" P.VC									
"		2 - C.O									
"		2 - FERNCO'S									
"		1 - 45° BEND									
"		1 - 22½ BEND									

DATE SEPT 18 1997

TOWN OF LEXINGTON — BOARD OF PUBLIC WORKS

SEWER DIVISION

Sketch of Service Here

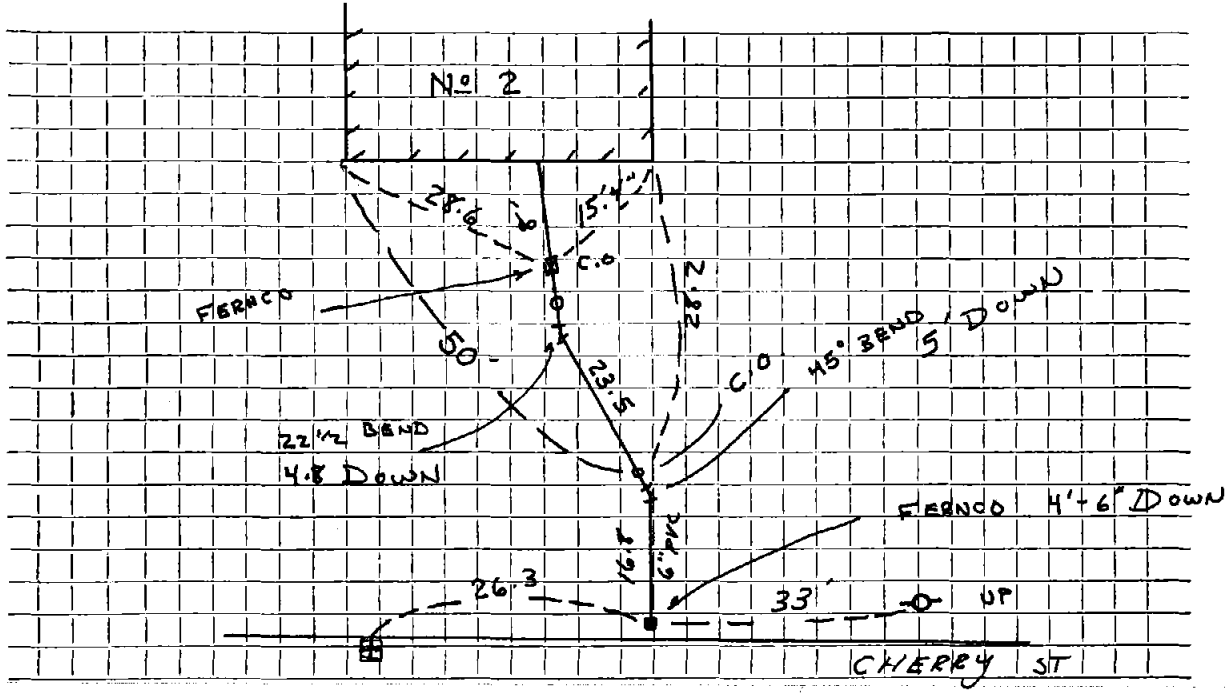

Connection made in CHERRY ST Street. Work completed Sean Tocci

Remarks:

FIELD BOOK 97-4 TIM

Name **Service No.**

Address 2 Cherry ST

Location

Kind of Pipe **Size** **Size of Main**

Repair—Renewal—New Service **Location**

Date	Material	Amount	Total	Date		Amount
					Outside	
	Inside			10-20-97	Repair	
					7½-6" PVC	
					1-6" PVC-PVC Fernco	
					1-6" CI-PVC Fernco	

DATE 12-5-97

TOWN OF LEXINGTON — BOARD OF PUBLIC WORKS

SEWER DIVISION

Sketch of Service Here

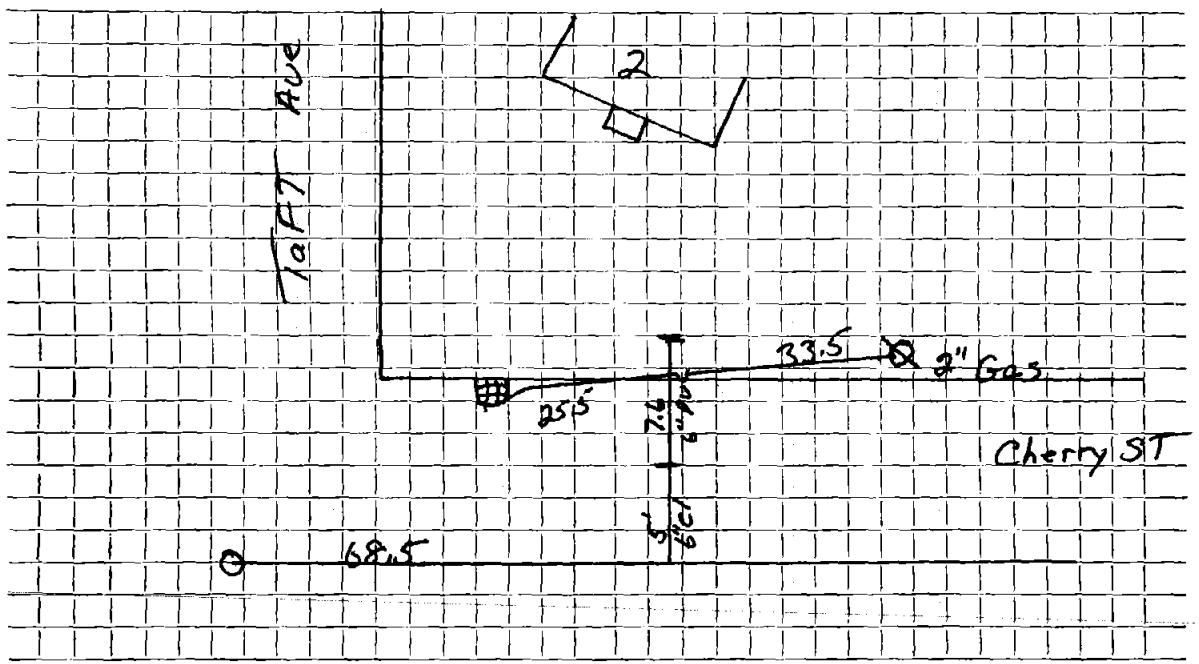

Connection made in ..... Street. Work completed ...10-20-97.....

Remarks: .....

.....