Name John Geaghan **Service No.**

Address 8 Churchill Lane

Location

Kind of Pipe Valeri Const. Co. Permit #A234 **Size** **Size of Main**

~~Repair Renewal~~ **New Service** **Location**

Date		Material	Amount		Total		Date			Amount	
Mar 66		Connect to easement									
4-15-66	57'	6" Transite pipe									

H.B.M.18501

DATE _____

TOWN OF LEXINGTON — BOARD OF PUBLIC WORKS

SEWER DIVISION

Sketch of Service Here 8

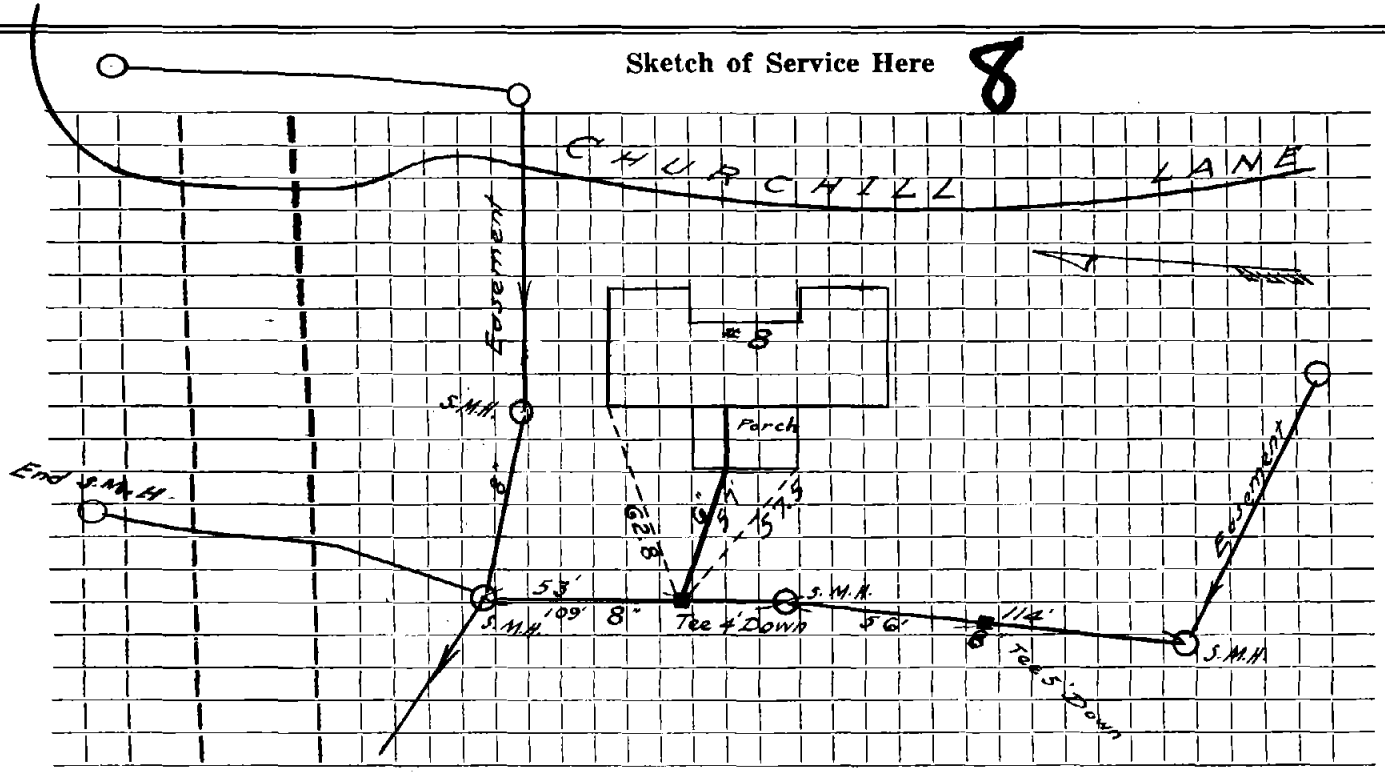

Connection made in ..... Street. Work completed .....

Remarks: .....

.....

.....

[redacted]