Name **Service No.**

Address #32 CLELLAND RD

Location

Kind of Pipe PVC **Size** 6" **Size of Main** 8"

Repair—Renewal—New Service **Location**

Date	Material	Amount	Total	Date		Amount
11-30-82	25' of 6" PVC	$16 00	$400 00			
	5' of 4" CI	No Charge				

DATE _____

TOWN OF LEXINGTON — BOARD OF PUBLIC WORKS

SEWER DIVISION

Sketch of Service Here

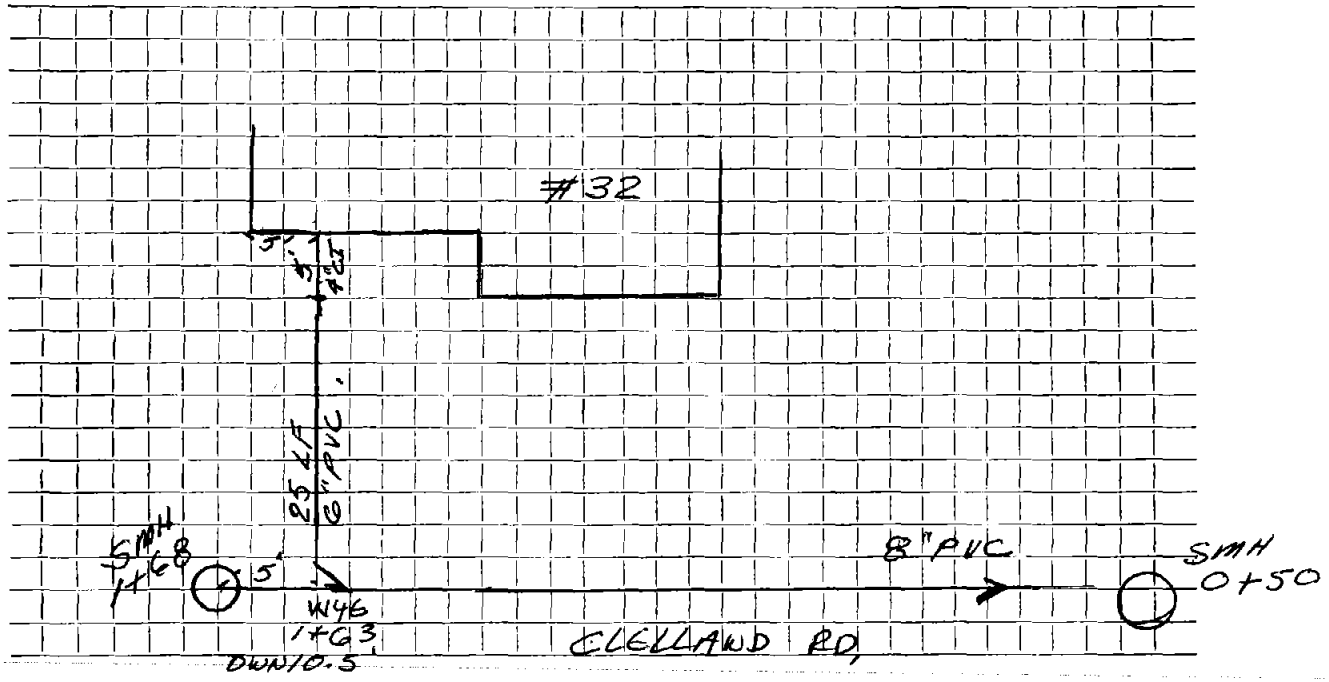

Connection made in ....CLELLAND RD.... Street. Work completed .....

Remarks: .....

.....

.....