Name Woodhaven Realty **Service No.**

Address 11 CLEMATIS Rd.

Location

Kind of Pipe PVC **Size** 6" & 4" **Size of Main** 8"

Repair—Renewal—New Service McLaughlin #4962 **Location**

Date	Material	Amount	Total	Date		Amount
2/11/88	6"-22° BEND					
	6" WYE CLEANOUT					
	6"x4" FERNCO					
	9 LF 4" PVC					
	81 LF 6" PVC					
7/11/86	8"x6" WYE					
	72 LF 6" PVC					

DATE _____

TOWN OF LEXINGTON — BOARD OF PUBLIC WORKS

SEWER DIVISION

Sketch of Service Here

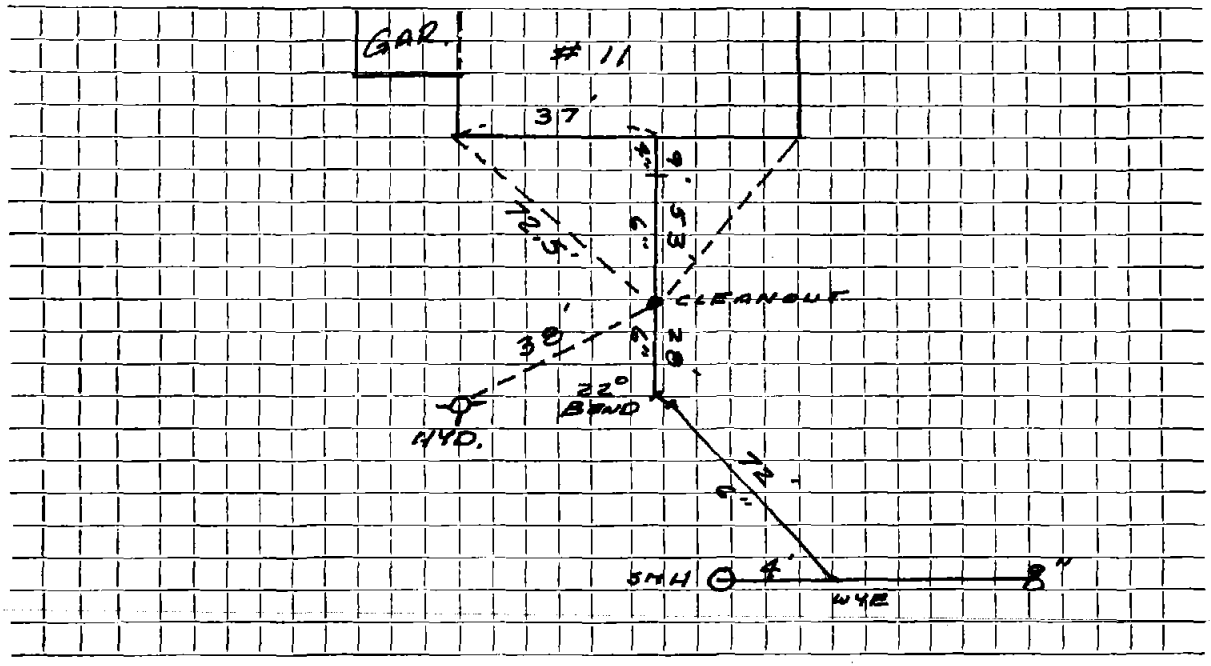

Connection made in CLEMATIS ..... Street. Work completed .....

Remarks: ...Subdivision.....

.....

[redacted]