**Name** **Service No.**

**Address** 12 Clematis Road (Lot 6)

**Location**

**Kind of Pipe** PVC **Size** 8" & 6" **Size of Main** 8"

**Repair—Renewal—New Service** **Location**

| Date | | Material | Amount | | Total | | Date | | | Amount | |
|---|---|---|---|---|---|---|---|---|---|---|---|
| | 83 | 3' - 8" PVC | | | | | | | | | |
| | 83 | 36' - 6" PVC | | | | | | | | | |

DATE _____

TOWN OF LEXINGTON — BOARD OF PUBLIC WORKS

# SEWER DIVISION

Sketch of Service Here

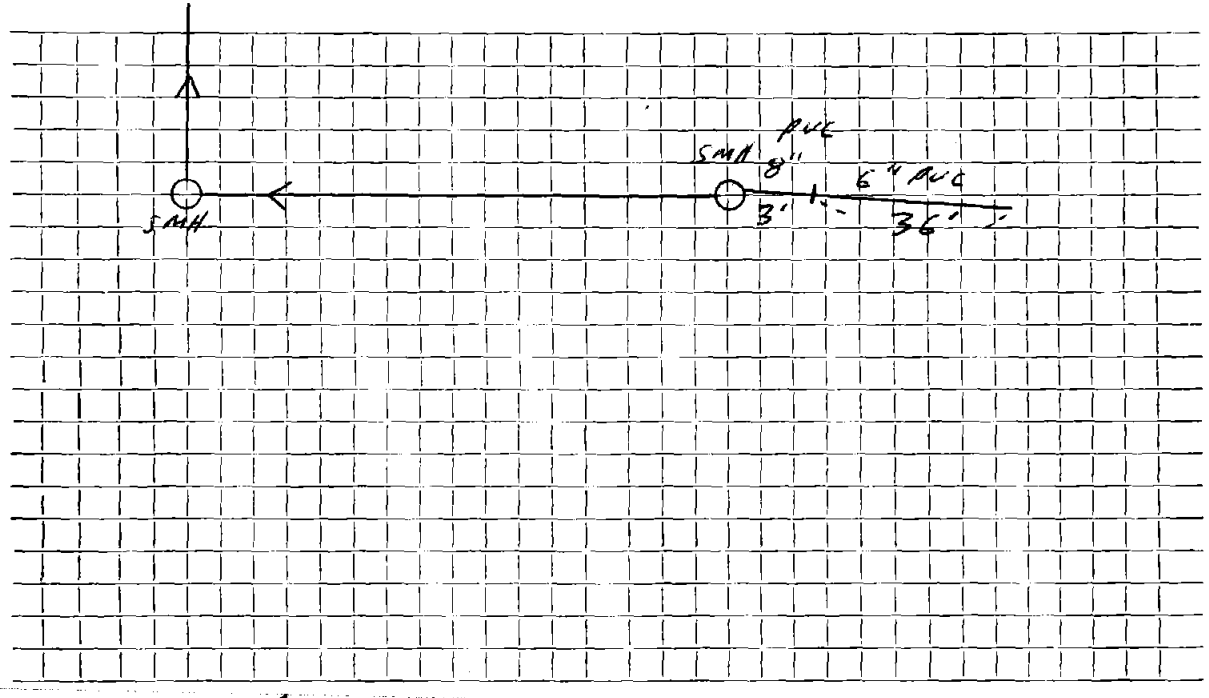


Connection made in Clematis Road ~~Street~~. Work completed .....

Remarks: .....

.....

.....