Name Mrs. Molina **Service No.**

Address 8 CLEMATIS RD.

Location

Kind of Pipe PVC **Size** 4" & 6" **Size of Main** 8"

Repair—Renewal—New Service McLaughlin #0053 **Location**

Date		Material	Amount		Total		Date			Amount	
5/17/	90	7 LF 4" PVC					4-24-90		Paid	256	00
		67 LF 6" PVC									
		4"x6" FERNCO									
		6" 11° BEND									
7/6/83	16'	6" PVC @ $16.00			$256.00						

DATE _____

TOWN OF LEXINGTON — BOARD OF PUBLIC WORKS

SEWER DIVISION

Sketch of Service Here 8

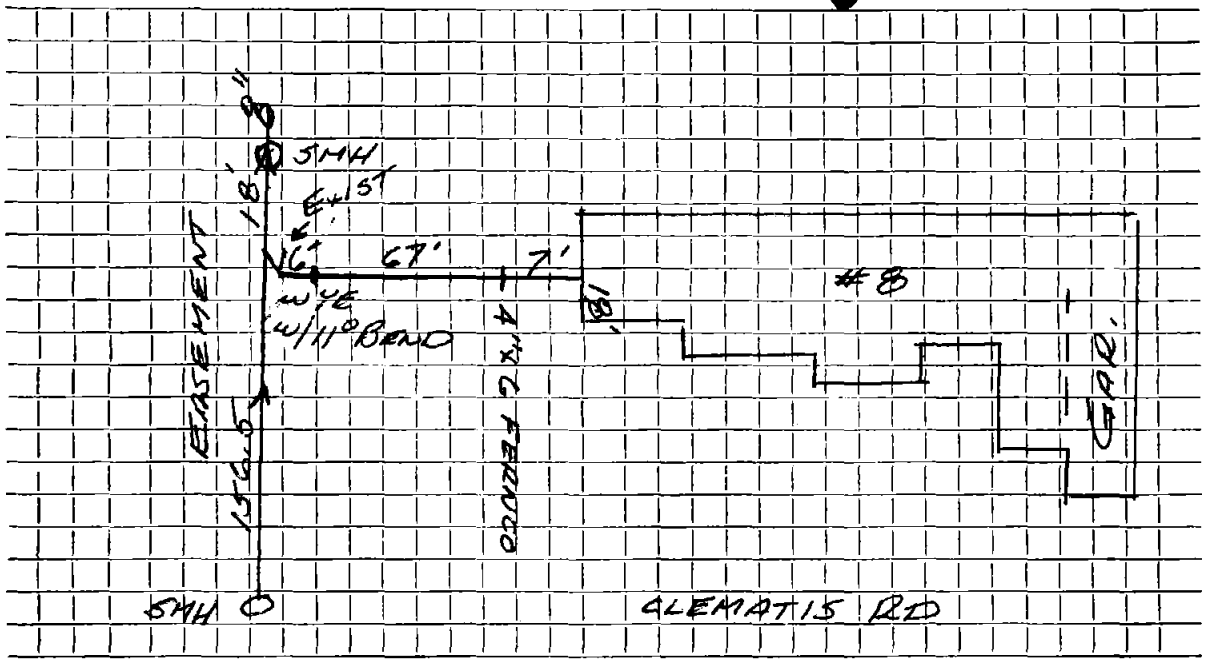

Connection made in EASEMENT Street. Work completed .....

Remarks: WYE W/11° BEND & 16 LF ARE EXISTING