Name Kingston Homes Inc. **Service No.**

Address 3 Clyde Place

Lot #25 **Location**

Kind of Pipe **Size** **Size of Main**

Repair—Renewal—New Service Kingston Homes # **Location**

Date		Material	Amount		Total		Date			Amount	
~~9/12/66~~	~~201~~	~~6" Transite pipe~~									
12/19/66		65' ~~4~~ 6" Transite									
		10' 4" Cast Iron					9-12-66				
								20'	6" Transite		

H.B.M.18501

DATE _____

TOWN OF LEXINGTON — BOARD OF PUBLIC WORKS

SEWER DIVISION

Sketch of Service Here **3**

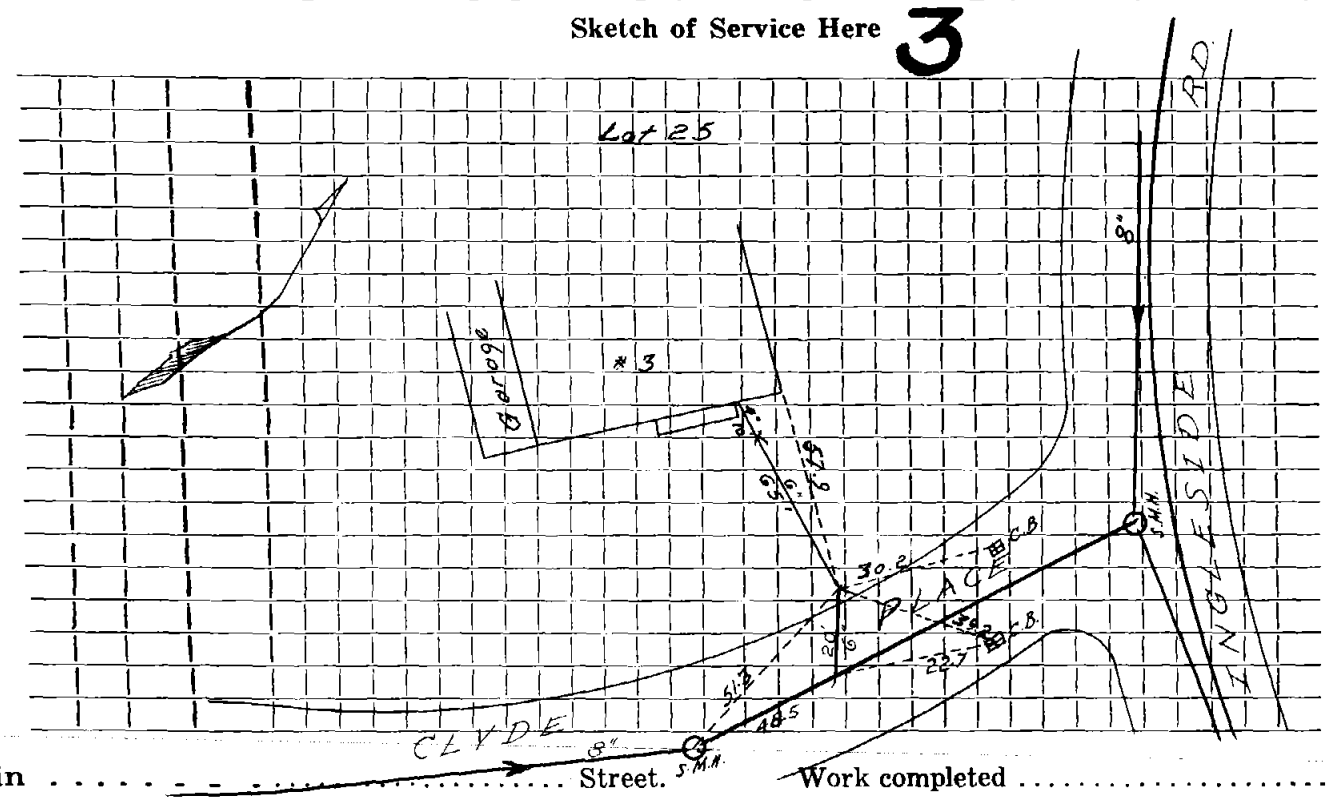

Connection made in ..... Street. Work completed .....

Remarks: .....

.....

.....