Name William H. O'Connell **Service No.** 114

Address 5 COACH RD

Location

Kind of Pipe AC **Size** 6" **Size of Main** 8"

Repair—Renewal—New Service Craftsman, Incorporated #2757 **Location** AUG 16 1976

Date		Material	Amount		Total		Date			Amount	
~~7-31-75~~		~~28' 6" AC~~	$10.	00	$280	00	10/21/5		Deposit	280	00
11/21/75	106'	6" Transite Pipe									
	10'	4" Cast Iron Pipe					7-31-	75			
								28'	6" A C.		

.B.8.18501

DATE _____

TOWN OF LEXINGTON — BOARD OF PUBLIC WORKS

SEWER DIVISION

5

Sketch of Service Here

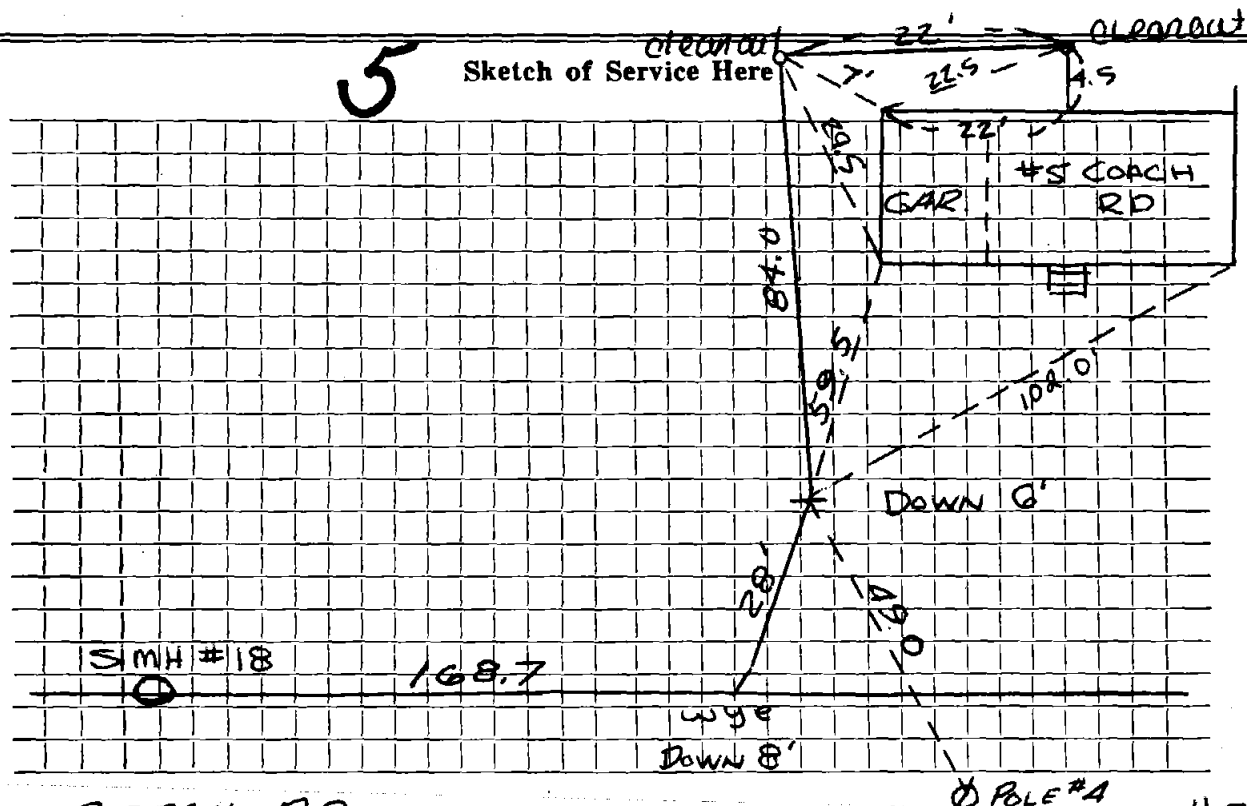

Connection made in ...COACH RD..... Street. Work completed .....11-21-75.....

Remarks: .....

.....

.....