Name | Service No.

Address 34A Colony Road

Location

Kind of Pipe | Size | Size of Main

Repair—Renewal—New Service | Location

Date		Material	Amount		Total		Date			Amount	
12-27-48											
	110'	6" Sewer Pipe									

DATE _____

TOWN OF LEXINGTON — BOARD OF PUBLIC WORKS

SEWER DIVISION

Sketch of Service Here 34A

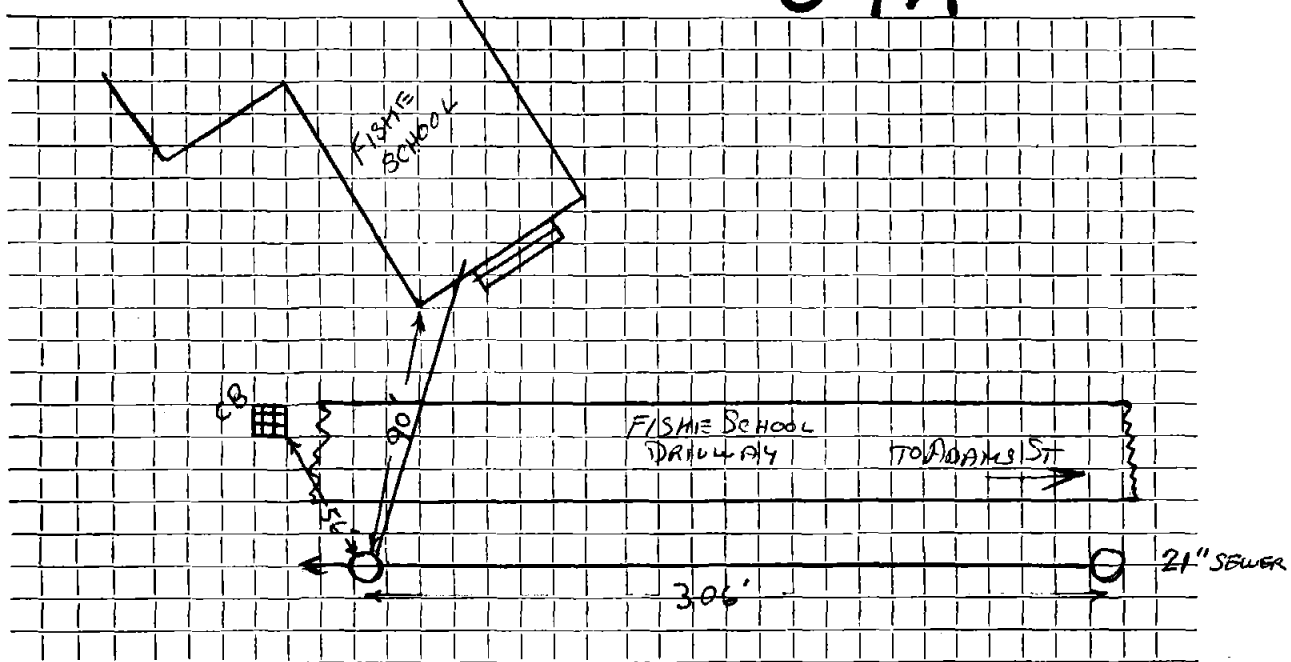

Connection made in 21" TRUNK SEWER ..... Street. Work completed .....

Remarks: .....

.....

.....