Name Robert G. Martin **Service No.** 92

Address 21 Columbus Street

Location

Kind of Pipe **Size** **Size of Main**

Repair—Renewal—New Service Lexington Sewerage #1200 **Location** JAN 27 1969

Date		Material	Amount	Total	Date		Amount
4-30-65	30'	6" Transite pipe @7.00		210.00	5-25-65	Deposit	210 00
11-6-68	160'	6" Transite pipe					
	88'	4" C					

H.B.M.18501

DATE _____

TOWN OF LEXINGTON — BOARD OF PUBLIC WORKS

SEWER DIVISION

Sketch of Service Here 21

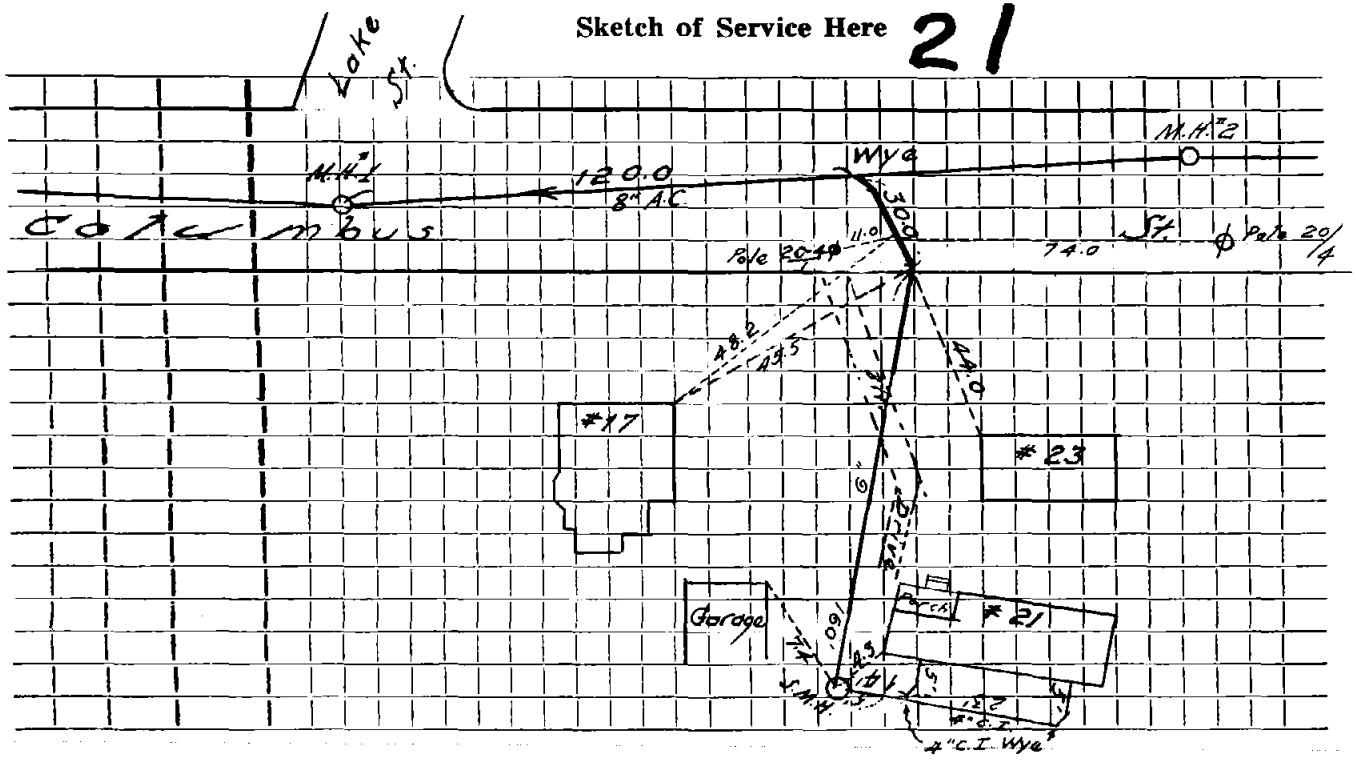

nnection made in ..... Street. Work completed .....

marks: .....

.....

.....