Name Richard Balmer **Service No.** 40

Address #272 CONCORD AVE.

Location

Kind of Pipe AC **Size** 6" **Size of Main** 8"

Repair—~~Renewal—New Service~~ XXXXXXXXXXXXXXXXXX Kirkland #4549 **Location** NOV 19 1984

Date		Material	Amount		Total		Date			Amount	
~~7-13~~	~~76~~	~~30'f-6" AC~~ @	10.00	=	$ 300.	00	10-4-84		Deposit	300	00
10/4/84	70'	x 6" PVC									
	2	6" x 22½° Elbow					7-13-	76			
	1	6" ACP x PVC Adaptor						30'	6" A.C.		
	1	6" x 4" Donut									

F.B.K.18501

DATE 9-28-76

TOWN OF LEXINGTON — BOARD OF PUBLIC WORKS

SEWER DIVISION

Sketch of Service Here 272

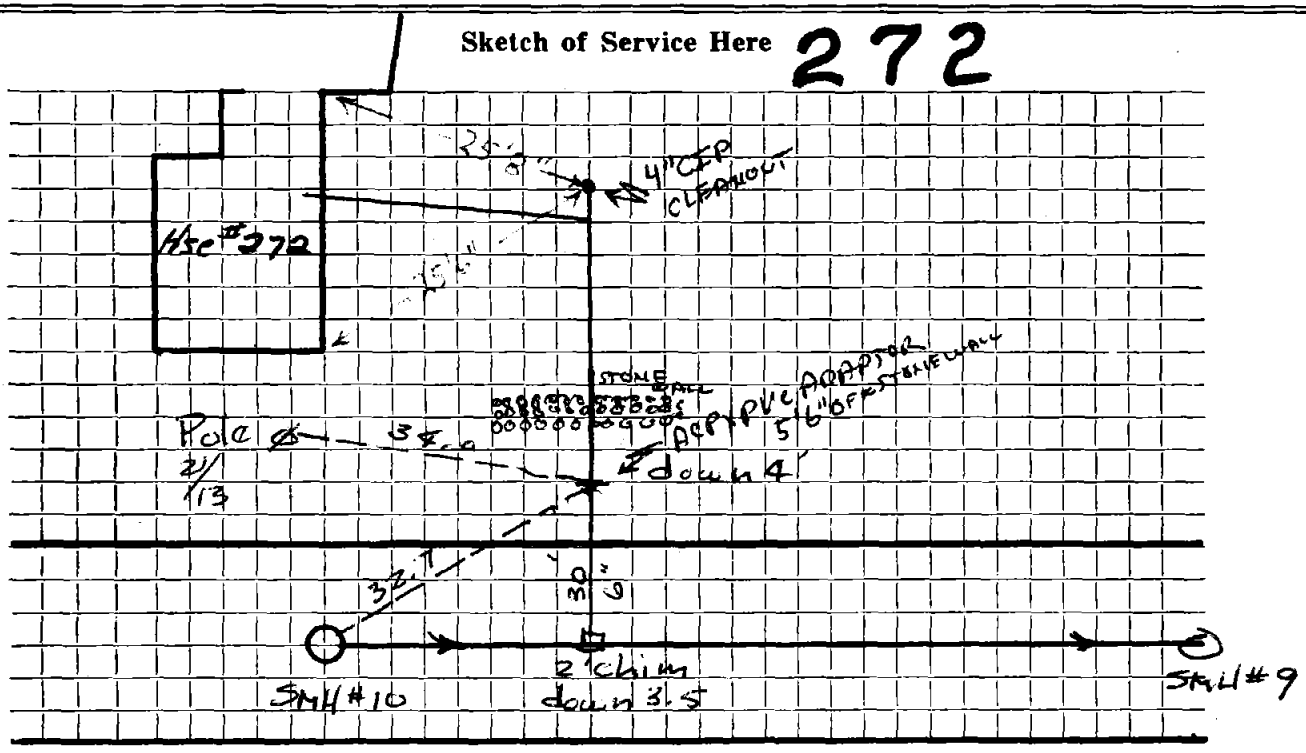

Connection made in Concord Ave. Street. Work completed .....

Remarks: .....

.....

.....