1976

Name George Ellenbogen **Service No.** 100

Address 330 Concord Ave

~~JUN 20 1977~~

Location

Kind of Pipe AC **Size** 6" **Size of Main** 8"

~~Repair Renewal~~—**New Service** Valeri #2998 **Location**

Date		Material	Amount		Total		Date			Amount	
~~7-19-76~~		~~23 lf 6" AC~~	10.00	=	$230.	00	11/10/76		Deposit	230.	00
12/2/76	91'	6" transite pipe									
	10'	4" cast iron					7-19-76				
								23'	6" A.C.		

F.B.K.18501

DATE 9-29-76

TOWN OF LEXINGTON — BOARD OF PUBLIC WORKS

SEWER DIVISION

330 Sketch of Service Here

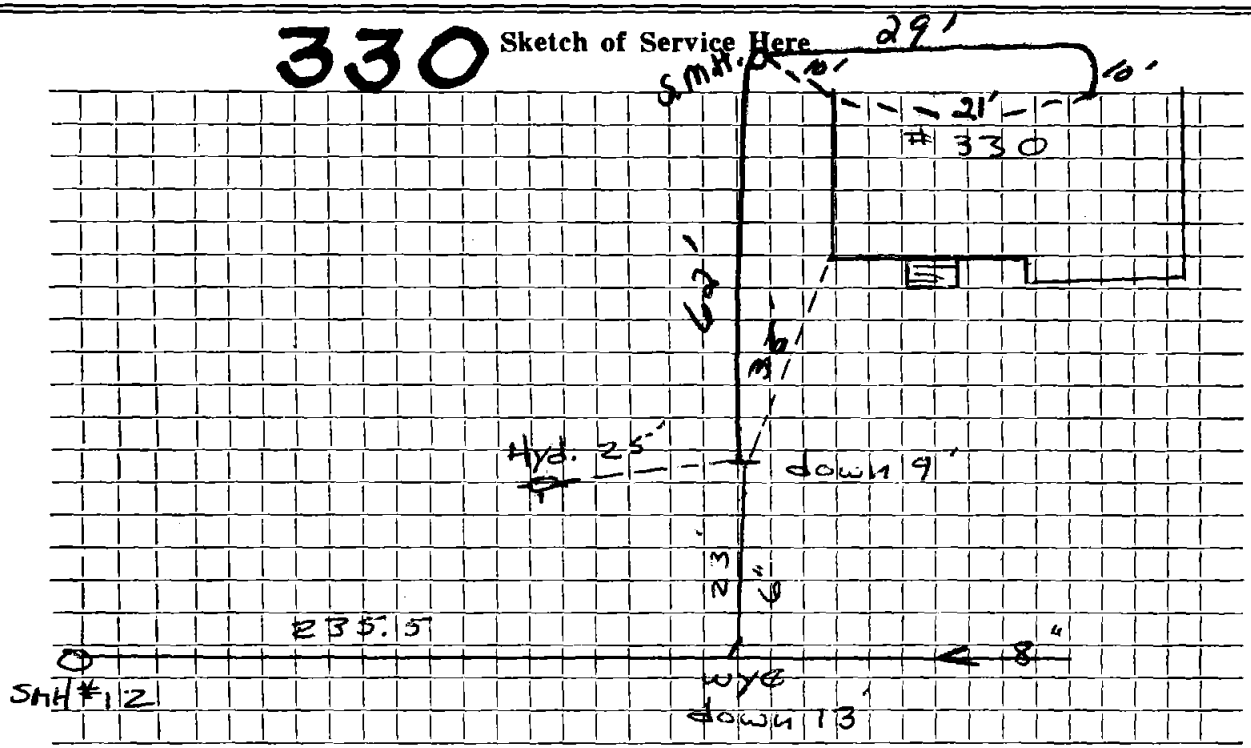

Connection made in Concord Ave Street. Work completed .....

Remarks: .....