Name Alan B. Wade **Service No.** 118

Address 524 Concord Avenue

Location Lot L.C.6

Kind of Pipe **Size** **Size of Main**

Repair—Renewal—New Service Devine #1981
Devine #1981 **Location** JUN 5 1972

Date		Material	Amount	Total
~~1971~~	~~19'~~	~~6" Transite pipe~~ @	12.00	228.00
12-13-71	61'	6" Transite pipe		
	10'	4" Cast Iron pipe		

Date			Amount
11-23-71		Deposit	228 00
	1971		
	19'	6" Transite	

B.M.18F01

DATE _____

TOWN OF LEXINGTON — BOARD OF PUBLIC WORKS

SEWER DIVISION

Sketch of Service Here 524

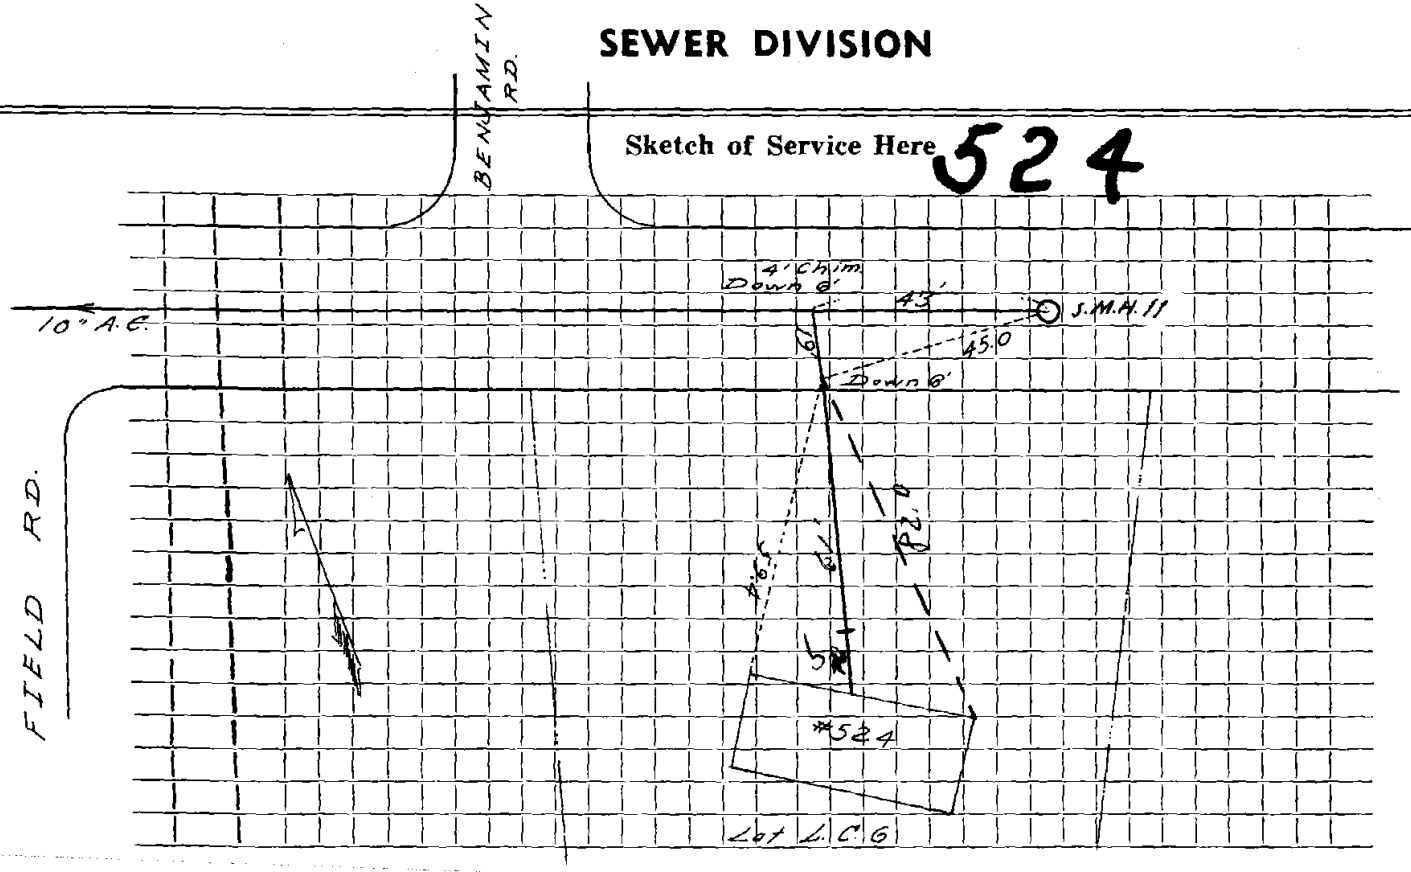

Connection made in . . . . . Street. Work completed . . . . . .

Remarks: . . . . . .

. . . . . .

. . . . . .