Name Com'lth of Mass - Fernald School **Service No.**

Address ~~76~~ CONCORD AVE

72 (changed by Eng. 6-12-84 **Location**

Kind of Pipe P.V.C & C.I.P. **Size** 6" & 4" **Size of Main** 8" PVC

~~**Repair**~~ ~~**Renewal**~~ **New Service** Baptiste **Location** Comm May 10, 1984

Date		Material	Amount	Total	Date			Amount
~~9/25/80~~		~~26 LF of 6" PVC~~ @	$14.00 =	$364.00	2-13-84		Deposit	364 00
1/6/84	128'	x 4" C.I.P.						
	1	4" C.I. Wye			9-25-	80		
						26	6" PVC	

DATE 11-18-80

TOWN OF LEXINGTON — BOARD OF PUBLIC WORKS

SEWER DIVISION

Sketch of Service Here

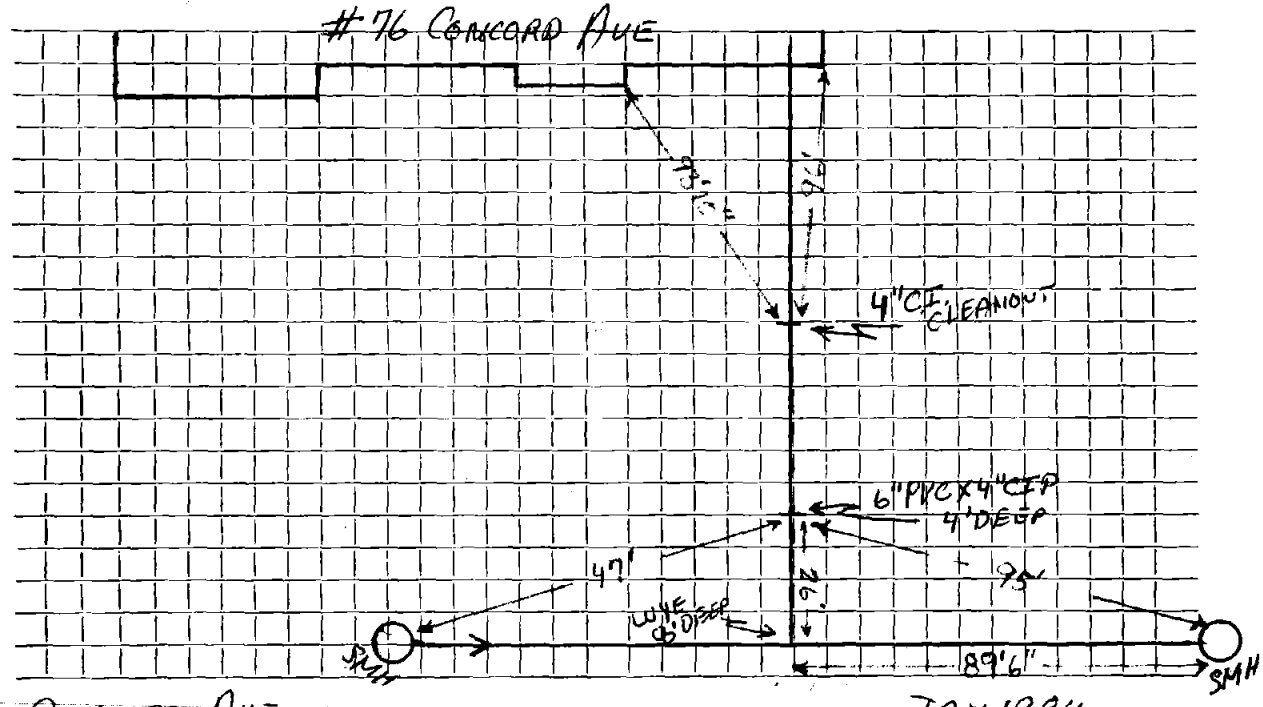

Connection made in CONCORD AVE Street. Work completed JAN 1984

Remarks: