[redacted]

Name *Woodhaven Realty* **Service No.**

Address *9 Constitution Road*

Location

Kind of Pipe **Size** **Size of Main**

~~Repair~~ ~~Renewal~~ **New Service** *Arlex #4021* **Location**

Date		Material	Amount	Total	Date		Amount
6/12/85	*60'*	*6" PVC*					
	5'	*4" PVC*					
		8" x 6" Service Saddle					
	3'	*Chimney*					
	1	*45°*					
	1	*22°*					
	1	*4" x 6" Fernco*					

[redacted]

DATE _____

TOWN OF LEXINGTON — BOARD OF PUBLIC WORKS

SEWER DIVISION

Sketch of Service Here 9

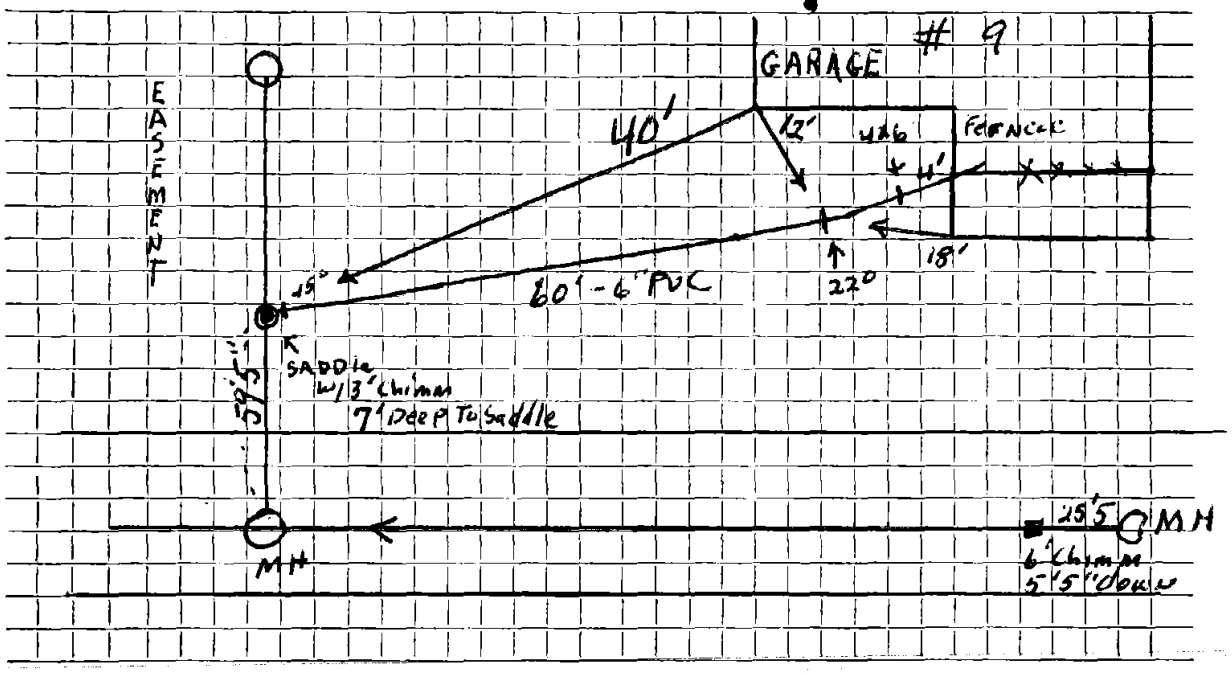

Connection made in ..... Street. Work completed .....

Remarks: Conn - in Easement did not use chim in St.