Name Richard Sorrentino Service No. 7

Address 18 Curve Street

Lexington, Mass. Location 18 Curve Street

Kind of Pipe Size Size of Main

~~Repair~~ ~~Remark~~ New Service Com. 5-2-49 Location

Date	Material	Amount	Total	Date		Amount
Mar. 24, '49	Labor	29 57	29 57	Mar. 10, '49	Deposited	60 00
	10% Overhead		2 96	May 5 '49	Refunded	3 82
	22' - 6" Sewer Pipe @.265		5 83			56 18
	Joint Compound		1 32			
	Trucking 2 hrs. @.75		1 50			
	Patching 15 x 3		15 00			
			56 18			
	Labor					
				2/3/77	Solids just outside house.	

HP-7919

TOWN OF LEXINGTON—DEPT. OF PUBLIC WORKS

SEWER DIVISION

DATE ..... NO. .....

The undersigned applies for the construction of a particular sewer connecting No. ..... Street and hereby agrees to comply with the Rules and Regulations governing the construction and use of Particular Sewers, as now or at any future time established by the Board of Selectmen.

Am't of estimate $. . . . . .

Am't Paid $. . . . . .

..... Owner

Sketch of Service Here

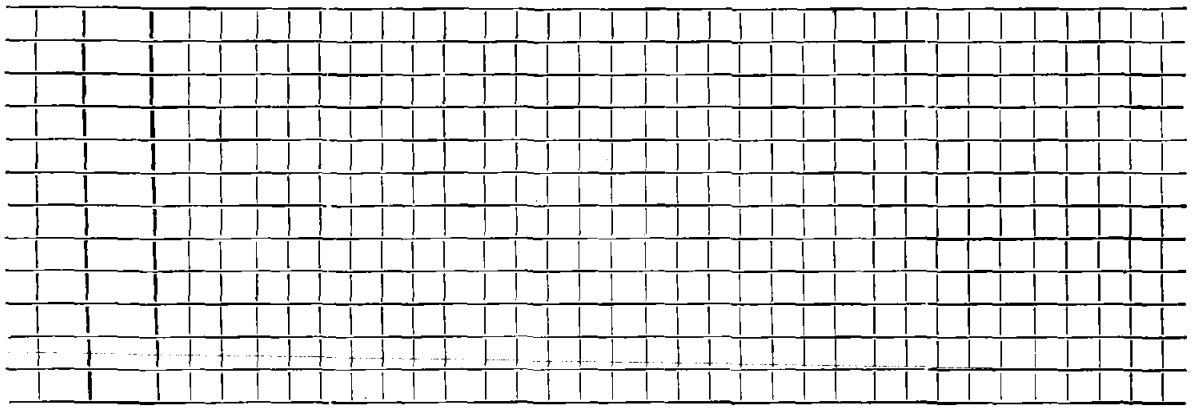

Connection made in . . .. Street. Work completed ..... 19..

Remarks: