Name

Service No. 1944

Address 10 Cutter Farm RD.

Location

Kind of Pipe PVC

Size 6"

Size of Main IN

Repair—Renewal—New Service T. Dunn J Mclaughlin

Location Dec 31-1970

Date		Material	Amount	Total	Date		Amount
10/27/05	6'6"	4" Sch 40					
	44'	6" PVC					
	1	4 x 6 Ferrnco					
	1	6"-22° bend					
	1	AC x PVC Ferrnco					
10/15/64	21'	Exist A.C.					

DATE _____

TOWN OF LEXINGTON — BOARD OF PUBLIC WORKS

SEWER DIVISION

Sketch of Service Here

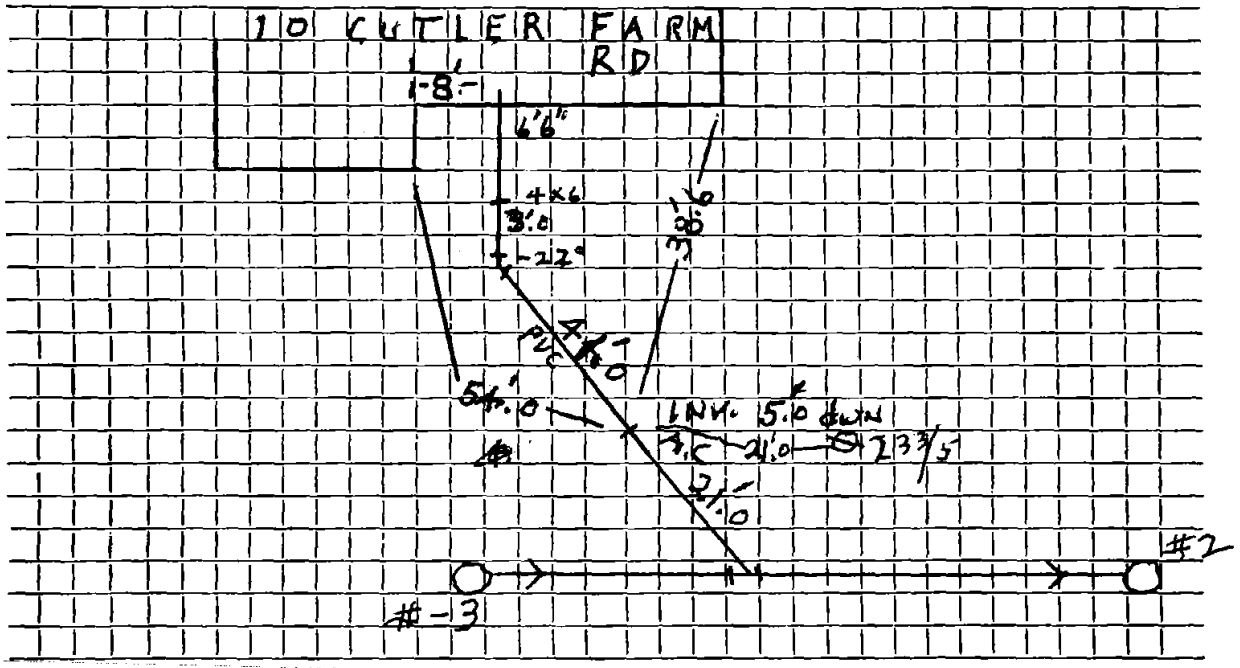

Connection made in ..... **Street.** **Work completed** 10/27/05 J. McLaughlin

Remarks: .....