Name Louis Ciampa **Service No.** 225

Address # 10 DANE RD.

Location LOT # 210

Kind of Pipe **Size** **Size of Main**

~~Repair-Renewal~~—New Service **Location** Comm 5-4-59

Date		Material	Amount		Total		Date			Amount	
4-3-59		Labor	16	03			12-26-59		Deposit	50	00
		10% O.H.	1	60	17	63	5-12-59		Paid	4	13
	50'	6" Transite Pipe@.70	35	00	35	00				54	13
	2	Hrs. Trucking @.75	1	50	1	50			NON CHARGE		
			54	13	54	13	4-3-59		Labor	36	69
								21'	6" Transite Pipe@.70	14	70
								4	Hrs. Town Shovel@6.50	26	00
								1	Hr. Trucking @3.00	3	00
								1	Hr. Rodgers Trailer	3	00
									26 x 3 Patch	26	00
										109	39
		Labor									
										4.13	

P-6411

TOWN OF LEXINGTON—DEPT. OF PUBLIC WORKS

SEWER DIVISION

DATE ..... NO. .....

The undersigned applies for the construction of a particular sewer connecting No. ..... Street and hereby agrees to comply with the Rules and Regulations governing the construction and use of Particular Sewers, as now or at any future time established by the Board of Selectmen.

Am't of estimate $.....

Am't Paid $.....

..... Owner

Sketch of Service Here

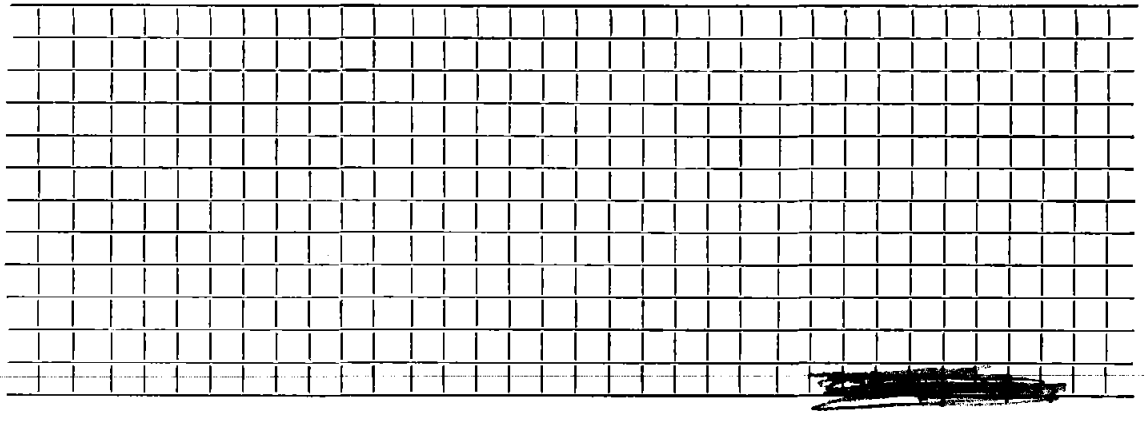

Connection made in ..... Street. Work completed ..... 19..

Remarks: