Name A. LaFauci & Son **Service No.** 143

Address 15 Dane Road

Lot #207 **Location**

Kind of Pipe **Size** **Size of Main**

~~Repair~~ ~~Renewal~~ **New Service** **Location** Comm 12-31-58

Date		Material	Amount	Total	Date		Amount
9-8-58		Labor	14.61		8-21-58	Deposit	30.00
		10% O.H.	1.46	16.07	12-31-58	Refund	8.07
	27'	6" Transite pipe @.70		18.90			41.93
	1	6" Transite Bend		6.21			
	1	hr. Trucking @.75		.75			
				41.93			
		Labor					

HP-6411

TOWN OF LEXINGTON—DEPT. OF PUBLIC WORKS

SEWER DIVISION

DATE . . . . . NO. . . . . .

The undersigned applies for the construction of a particular sewer connecting No. . . . . Street and hereby agrees to comply with the Rules and Regulations governing the construction and use of Particular Sewers, as now or at any future time established by the Board of Selectmen.

Am't of estimate $. . . . . .

Am't Paid $. . . . . .

. . . . . Owner

Sketch of Service Here

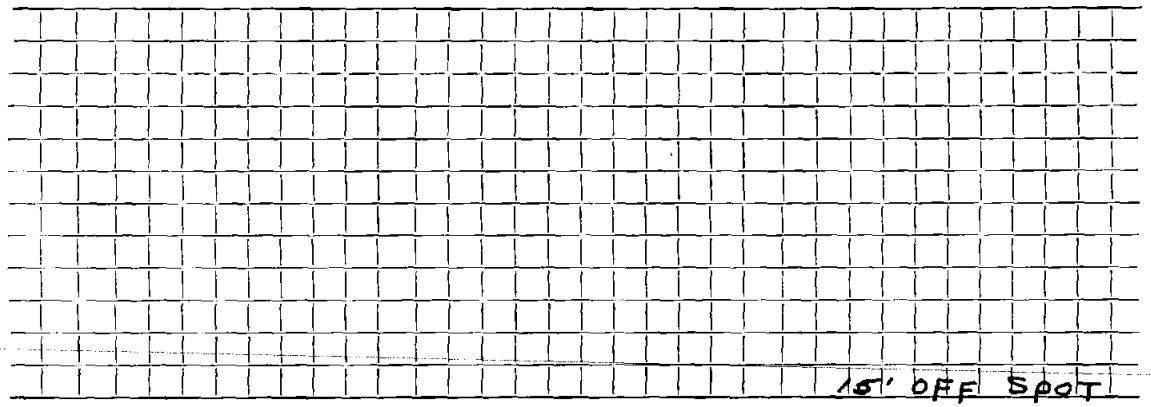

Connection made in . . . . . Street. Work completed . . . . . 19. .

Remarks: