Name **Service No.**

Address ~~3 FOSTER RD.~~ 8 Dane Rd.

Eng. change 10/24/02 **Location**

Kind of Pipe 6" PVC **Size** **Size of Main**

Repair—Renewal—New Service J. McLaughlin **Location**

Date		Material	Amount		Total		Date			Amount	
5/09/02	6'	4" PVC									
	43'	6" PVC									
	2	6" 22½° bends									
	1	4X6 Ferrnco									
	1	6"PVCXAC, Ferrnco									
EXISTING	PIPE	A.C.									

DATE _____

TOWN OF LEXINGTON — BOARD OF PUBLIC WORKS

SEWER DIVISION

Sketch of Service Here

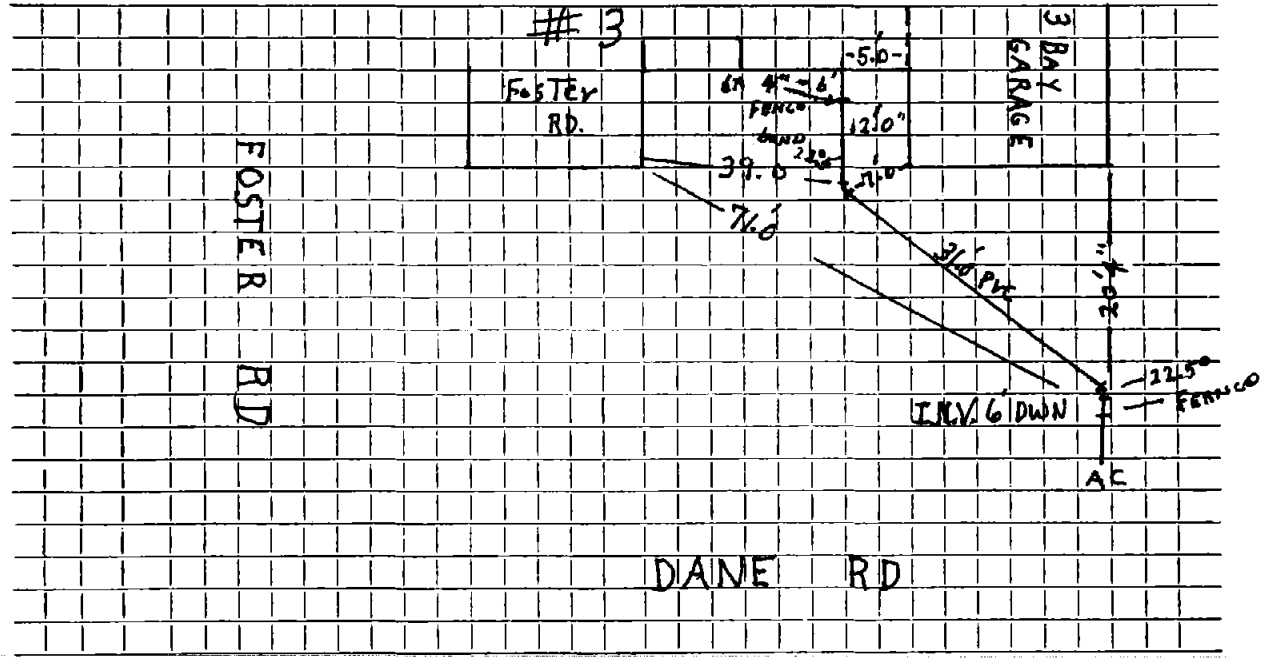

Connection made in DANE RD Street. Work completed .....

Remarks: .....

.....

.....