Name **Service No.** 2390

Address ~~22 TAFT AVE~~

1-Daniels-St. **Location** LOT 69

Kind of Pipe PVC **Size** 6" **Size of Main**

Repair—Renewal—New Service J. McLaughlin **Location**

Date		Material	Amount	Total	Date		Amount
3/21/07	6'	4" Sch 40					
	58'	6" PVC					
	1	6"-22° bend					
	1	4×6 Fernco					
	1	6" Clay × PVC Fernco					
		Sewer Stub 5.0' DWN	Under buffalo box				
Exist							
7/20/37	5T.	Clay Pipe					

DATE _____

TOWN OF LEXINGTON — BOARD OF PUBLIC WORKS

SEWER DIVISION

Sketch of Service Here

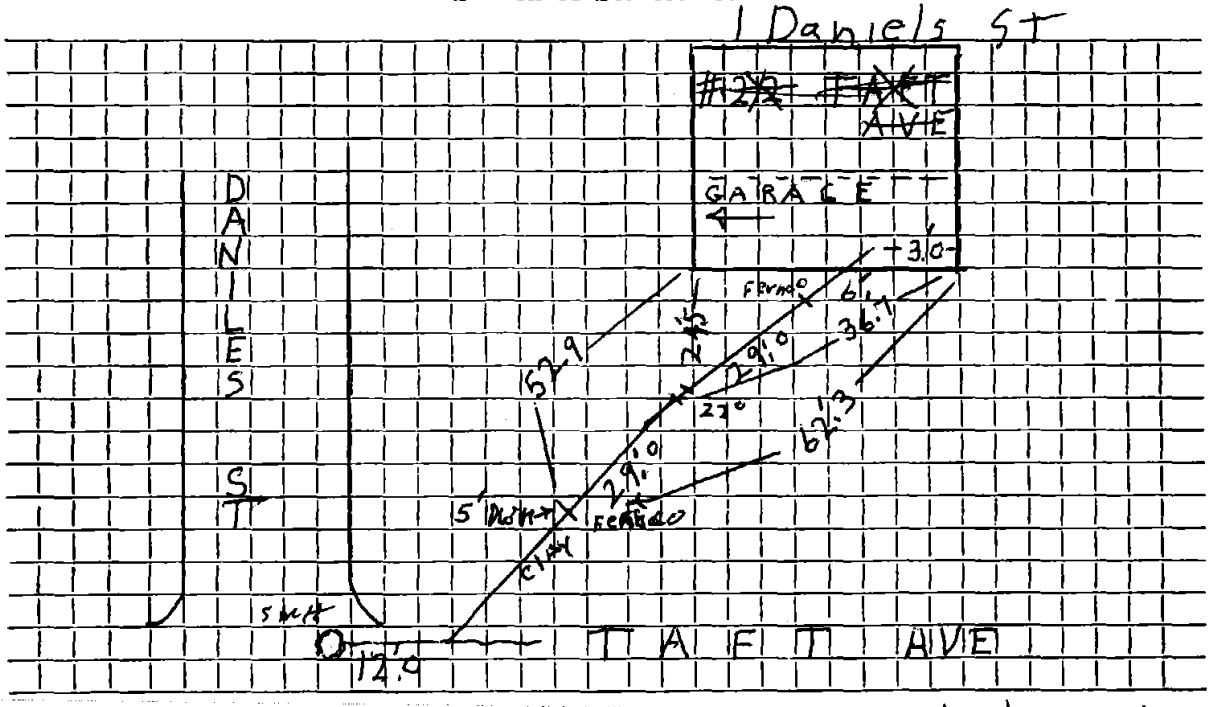

Connection made in ..... Street. Work completed 3/21/07 J. McLaughlin

Remarks: Sewer STUb Under Buffla Box