115

Name John G. Farnworth **Service No.**

Address 15 Dee Road

Lexington, Mass. **Location**

Kind of Pipe **Size** **Size of Main**

~~Repair~~ ~~Renewal~~ New Service **Location**

Date	Material	Amount	Total	Date		Amount
ept.30,'48	Labor	56 85	56 85	Sept 23 '48	Deposited	100 00
	10% Overhead		5 69	Dec 31 '48	Refunded	7 24
	46'—6" Sewer Pipe @ .26		11 96			92 76
	Joint Compound		2 76			
	2 hrs. Littlefield Shovel		14 00			
	2 hrs. Trucking		1 50			
			92 76			
	Labor					

19

TOWN OF LEXINGTON—DEPT. OF PUBLIC WORKS

SEWER DIVISION

DATE ..... NO. .....

The undersigned applies for the construction of a particular sewer connecting No. ..... - - ..... Street and hereby agrees to comply with the Rules and Regulations governing the construction and use of Particular Sewers, as now or at any future time established by the Board of Selectmen.

Am't of estimate $.....

Am't Paid $.....

..... - - ..... Owner

Sketch of Service Here

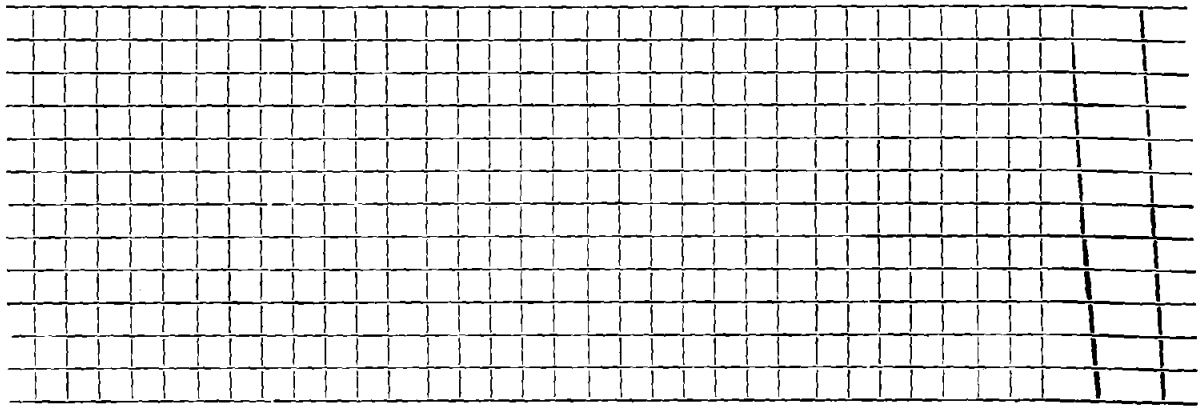

Connection made in ..... Street. Work completed .. - - ..... 19..

Remarks: