Name Bernard Budiansky **Service No.** 53

Address 11 Demar Rd Lot 18

Location

Kind of Pipe **Size** **Size of Main**

Repair—Renewal—New Service Craftsmen #651 **Location** JUL 24 1967

Date		Material	Amount		Total		Date			Amount	
~~1967~~	~~25'~~	~~6" Transite Pipe~~	~~@2.00~~		175	00	6-5-67		Deposit	175	00
6-19-67	86'	6" Transite pipe									
	30'	4" Cast Iron pipe									
								1967			
								25'	6" Transite		

.B.M.16501

DATE _____

TOWN OF LEXINGTON — BOARD OF PUBLIC WORKS

SEWER DIVISION

Sketch of Service Here

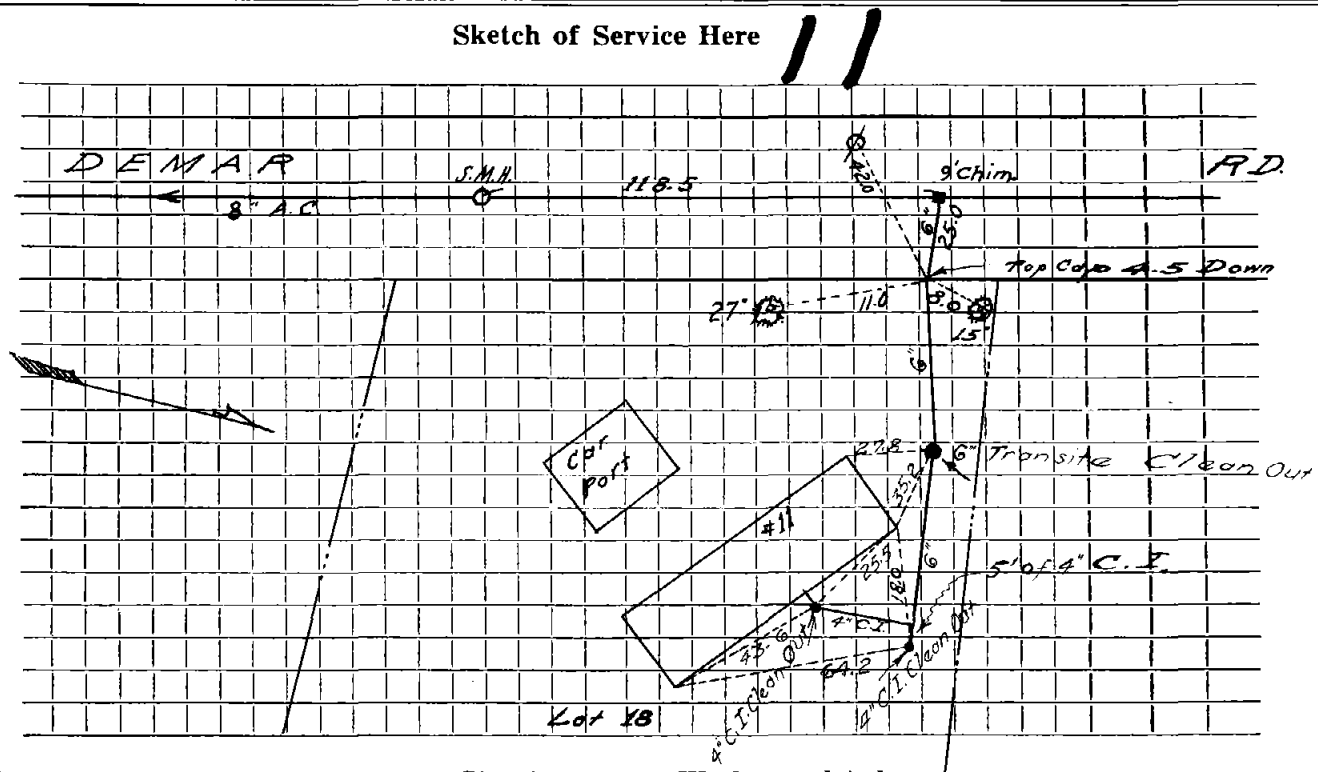

Connection made in ..... Street. Work completed .....

Remarks: .....

.....

.....