[redacted]

Name Thomas K. Dyer **Service No.** 55

Address 15 Demar Road Lot 17

Location

Kind of Pipe **Size** **Size of Main**

Repair—Renewal—New Service Aldo #646 **Location** JUL 24 1967

Date		Material	Amount		Total		Date			Amount	
~~1967~~	~~23'~~	~~6" Transite Pipe~~	@7.00		161	00	4-9-67		Dyer P	161	00
6-27-67	85'	6" Transite pipe									
	10'	4" Cast Iron pipe									
								1967			
								23'	6" Transite		

I.B.M.18501

DATE _____

TOWN OF LEXINGTON — BOARD OF PUBLIC WORKS

SEWER DIVISION

Sketch of Service Here 15

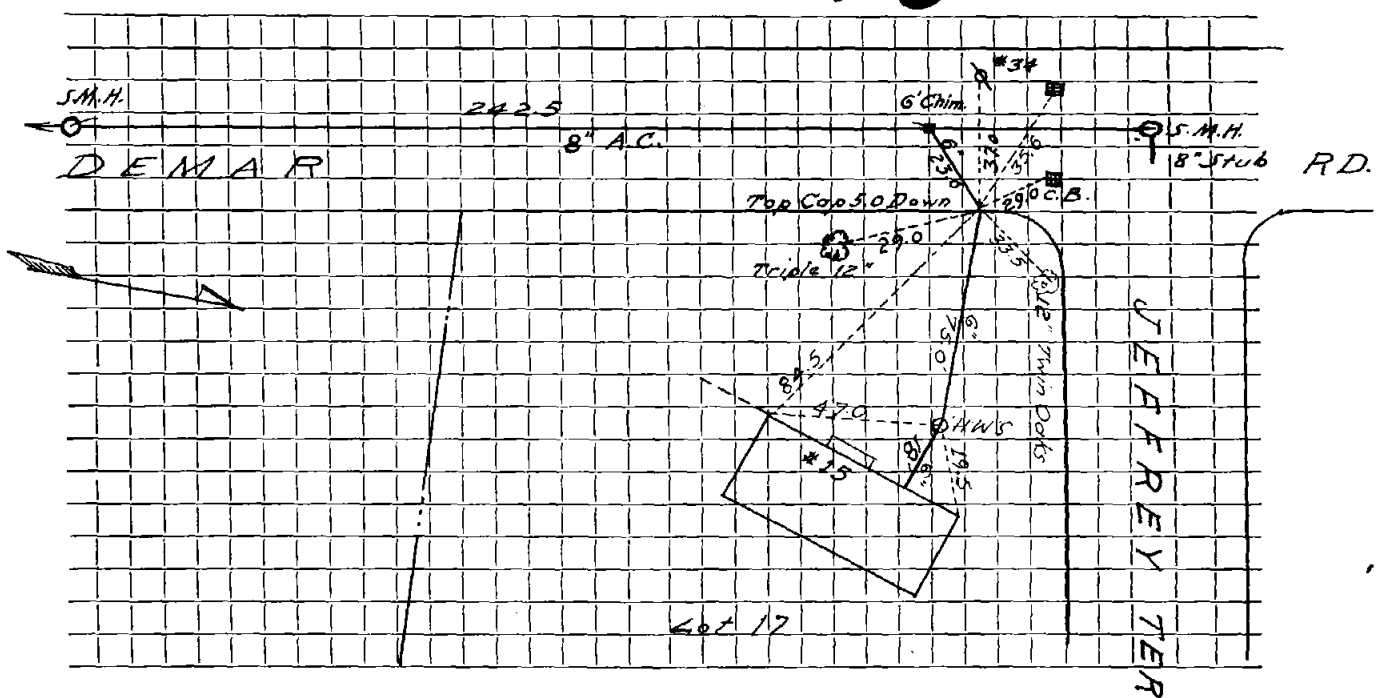

Connection made in ..... Street. Work completed .....

Remarks: .....

.....

.....