Name Wade Rockwood **Service No.** 13

Address 16 Demar Road Lot 9

Location

Kind of Pipe **Size** **Size of Main**

Repair—Renewal—New Service Craftsman #986 **Location** MAY 13 1968

Date		Material	Amount		Total		Date			Amount	
~~1967~~	~~25'~~	~~6" Transite Pipe~~	~~@ 7.00~~		175	00	4-4-68		Deposit	175	00
-11-68	80'	6" Transite pipe									
	10'	4" Cast Iron pipe									
								1967			
								25'	6" Transite		

I.B.M.18501

DATE _____

TOWN OF LEXINGTON — BOARD OF PUBLIC WORKS

SEWER DIVISION

Sketch of Service Here 16

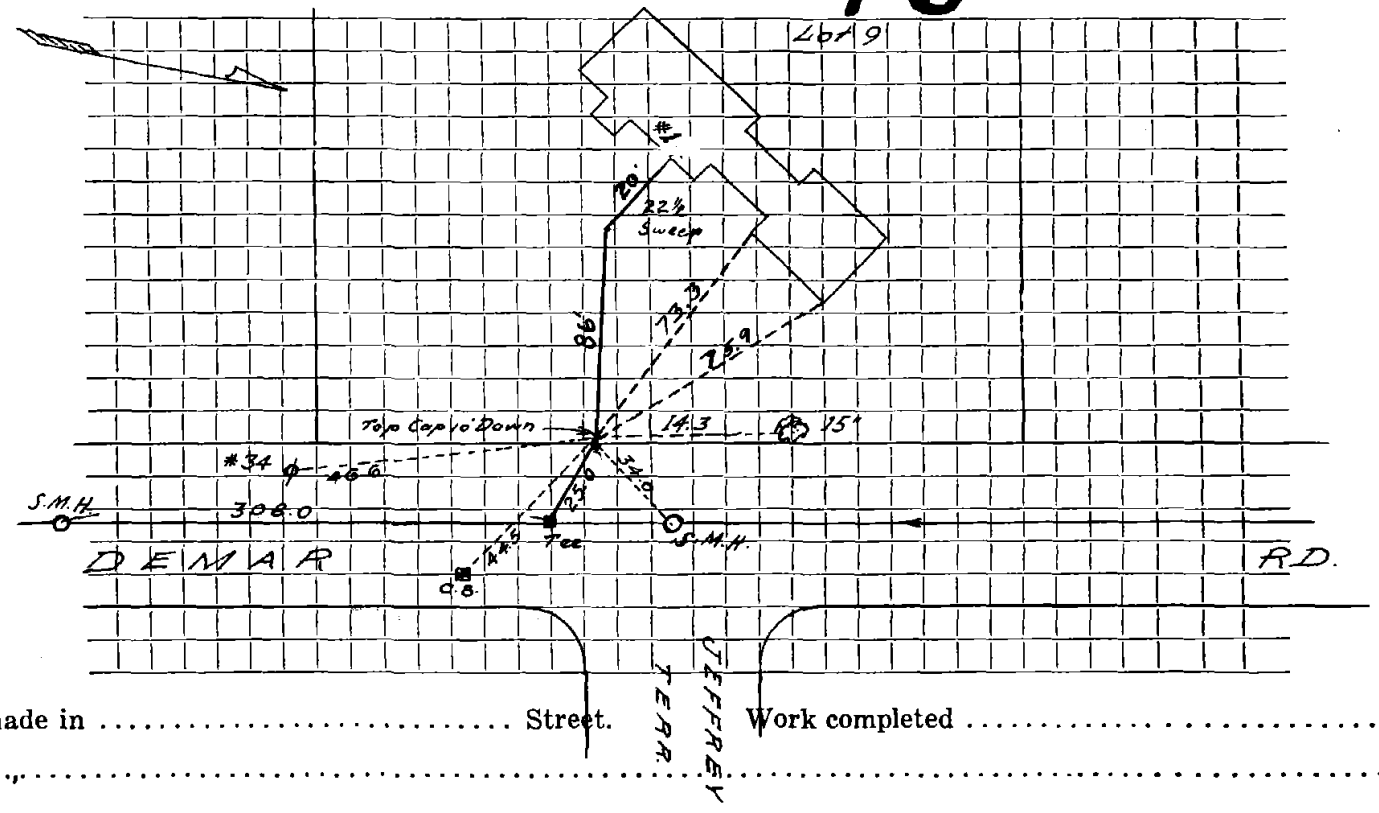

Connection made in ..... Street. Work completed .....

Remarks: .....

.....

.....