Name Morton Cohen **Service No.** 16

Address 7 Demar Road

Location

Kind of Pipe **Size** **Size of Main**

~~XRepairXRenewalX~~ **New Service** Valeri #3574 **Location**

Date		Material	Amount	Total	Date			Amount
~~1967~~	~~25'~~	~~6" Transite pipe~~	@ $7.00	175.00				
4-30	81							
	176'	6" A.C. Pipe				1967		
	2	6"-22° Elbow				25'	6" Transite	
	3	6"-22° Bends						
	1	6"- Wye						
	1	6"-11 1/4° Elbow						

DATE _____

TOWN OF LEXINGTON — BOARD OF PUBLIC WORKS

SEWER DIVISION

Sketch of Service Here 7

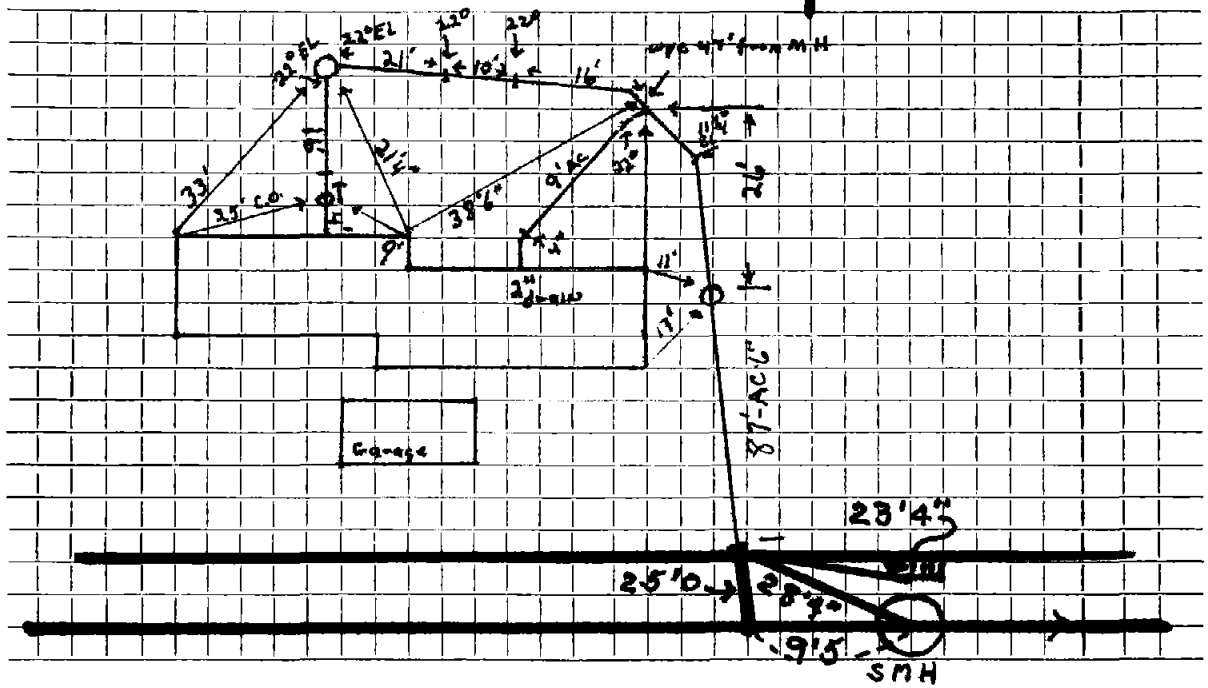

Connection made in ..... Street. Work completed .....

Remarks: .....