Name George Kolovson **Service No.** 105

Address # 10 Dewey Road #10 [illegible]

Lot 10 **Location**

Kind of Pipe **Size** **Size of Main**

Repair—Renewal—New Service Trebino #2129 **Location** AUG 14 1972

Date		Material	Amount		Total		Date			Amount	
~~Oct.'67~~	~~23'~~	~~6" Transite pipe~~	~~@6.50~~		149.50						
3-3-72	136'	6" Transite pipe									
	8'	4" Cast Iron pipe					10- -	67			
								23'	6" Transite		

H.B.M.18501

DATE _____

TOWN OF LEXINGTON — BOARD OF PUBLIC WORKS

SEWER DIVISION

Sketch of Service Here 10

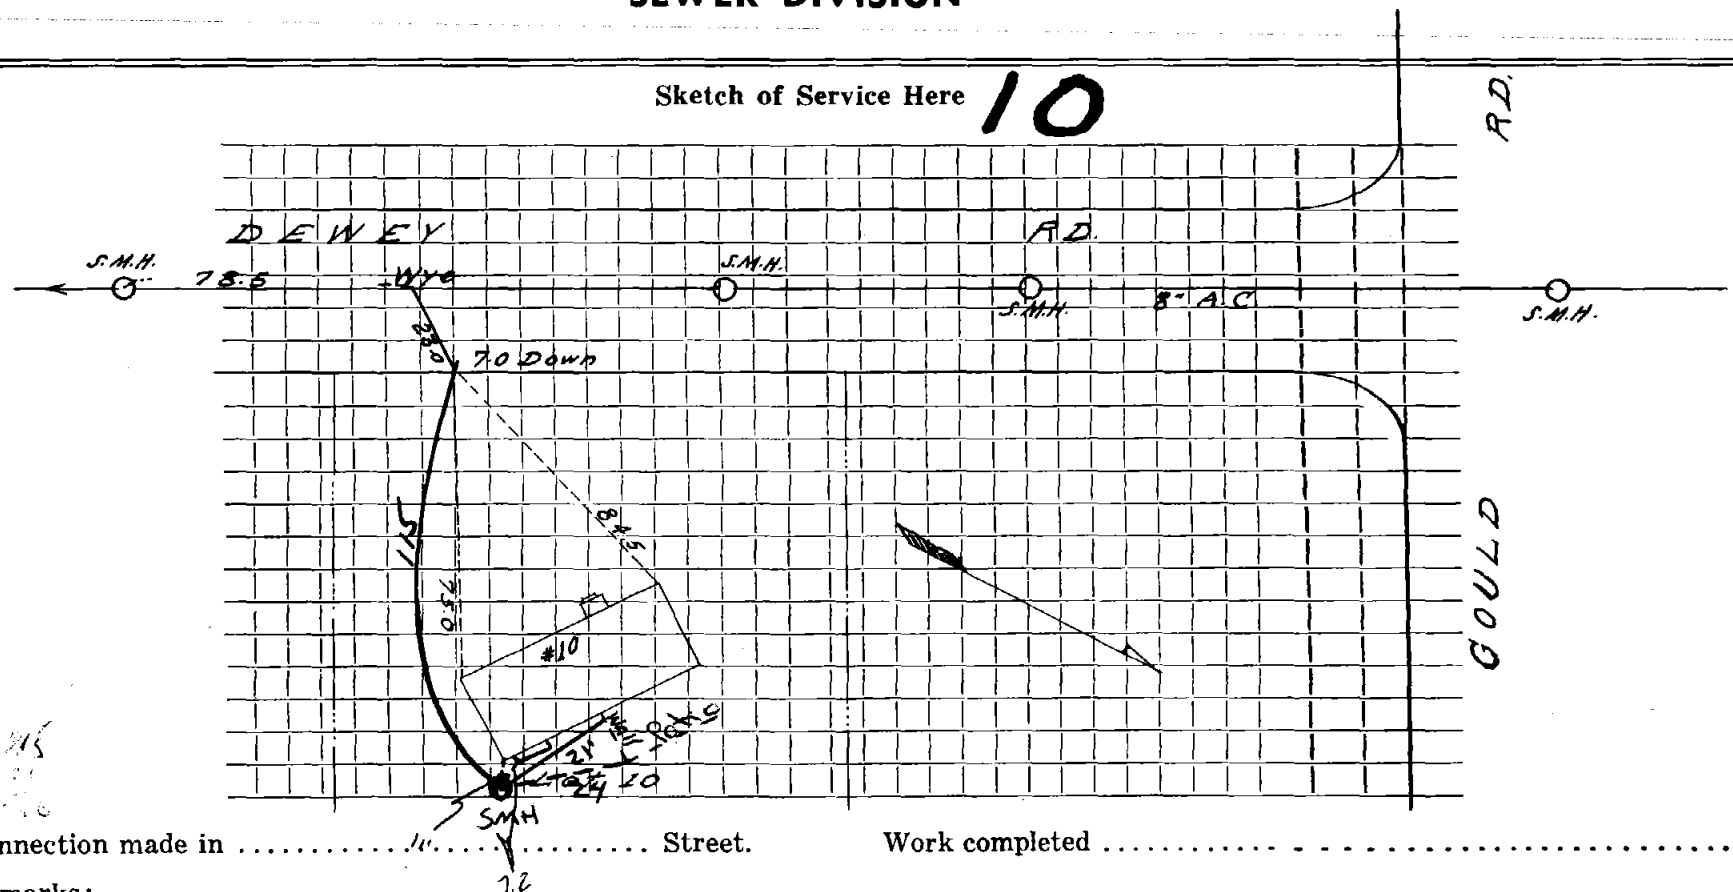

Connection made in ..... Street. Work completed .....

Remarks: .....

.....

.....