Name John Frankovich **Service No.** 103

Address # 19 Dewey Road

Lot 26 **Location**

Kind of Pipe **Size** **Size of Main**

Repair—Renewal—New Service Ferrari #1367 **Location** MAY 27 1969

Date		Material	Amount		Total		Date			Amount	
~~Oct. '67~~	~~26'~~	~~6" Transite pipe~~ @	6.50		169.	00	10-17-68		Deposit	169	00
-29-69	106'	6" Transite pipe									
	43'	4" Cast Iron pipe					10-	-67			
								26'	6" Transite		

B.M.18501

DATE _____

TOWN OF LEXINGTON — BOARD OF PUBLIC WORKS

SEWER DIVISION

Sketch of Service Here 19

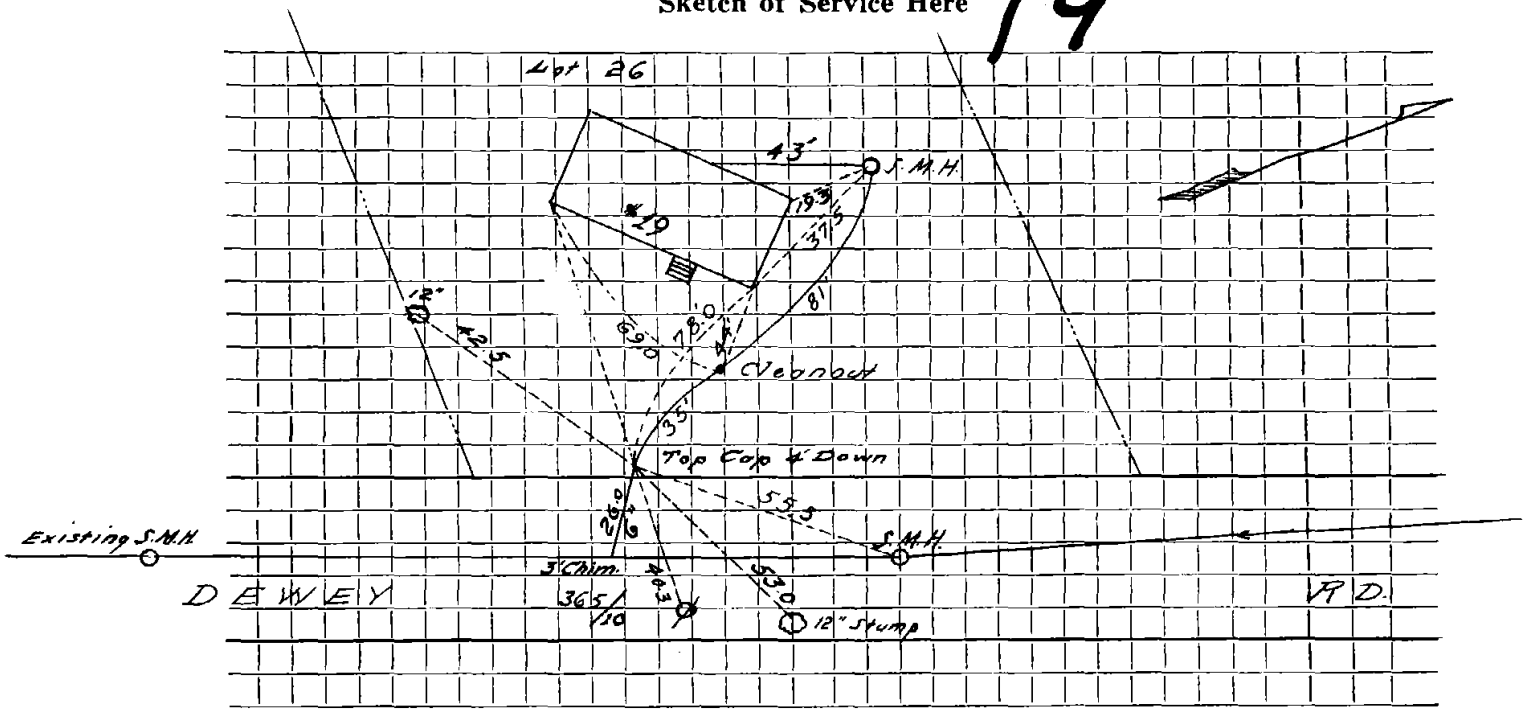

Connection made in ..... Street. Work completed .....

Remarks: .....

.....

.....