Name Gerald D. Shirley **Service No.**

Address 29 Dewey Road

Lot 41 **Location**

Kind of Pipe **Size** # 519 **Size of Main**

~~Repair~~ ~~Renewal~~ **New Service** J.M.Lucente Permit #34 Lexington Sewerage **Location**

Date	Material	Amount	Total	Date		Amount
~~July 1/64~~	~~35' 6" Transite pipe~~					
1/25/67	110' 6" Transite					
	10' 6" Cast Iron			7- -64		
					35' 6" Transite	

B.M.18501

DATE _____

TOWN OF LEXINGTON — BOARD OF PUBLIC WORKS

SEWER DIVISION

Sketch of Service Here 29

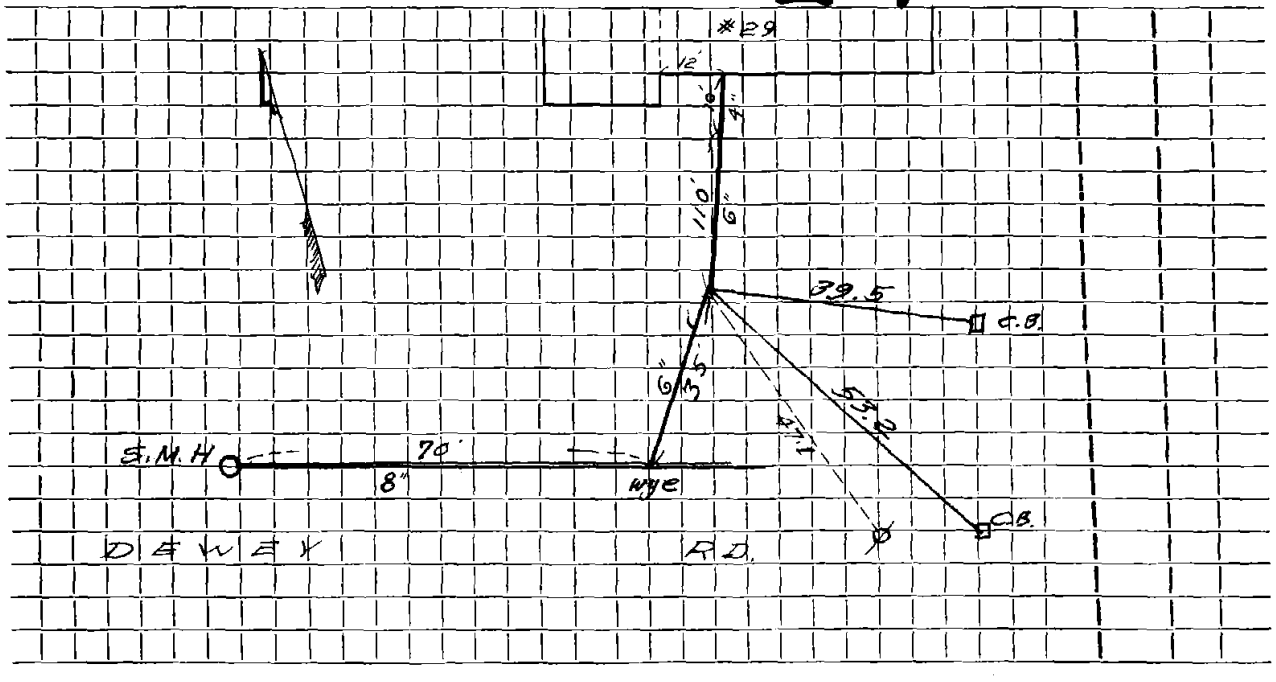

Connection made in ..... Street. Work completed .....

Remarks: .....

.....

.....