Name Barry H. Wiley **Service No.** 44

Address # 7 Dewey Road JUN 18 1973

Lot 18 **Location**

Kind of Pipe **Size** **Size of Main**

~~Replacement~~ New Service Trebino #2316 **Location**

Date		Material	Amount		Total		Date			Amount	
~~Oct. '67~~	~~21'~~	~~6" Transite pipe~~	~~@6.50~~		136.	50	5-15-73		Deposit	136	50
/16/73	74'	6" Transite									
	4'	4" Cast Iron					10- -	67			
								21'	6" Transite		

B.M.18501

DATE _____

TOWN OF LEXINGTON — BOARD OF PUBLIC WORKS

SEWER DIVISION

Sketch of Service Here 7

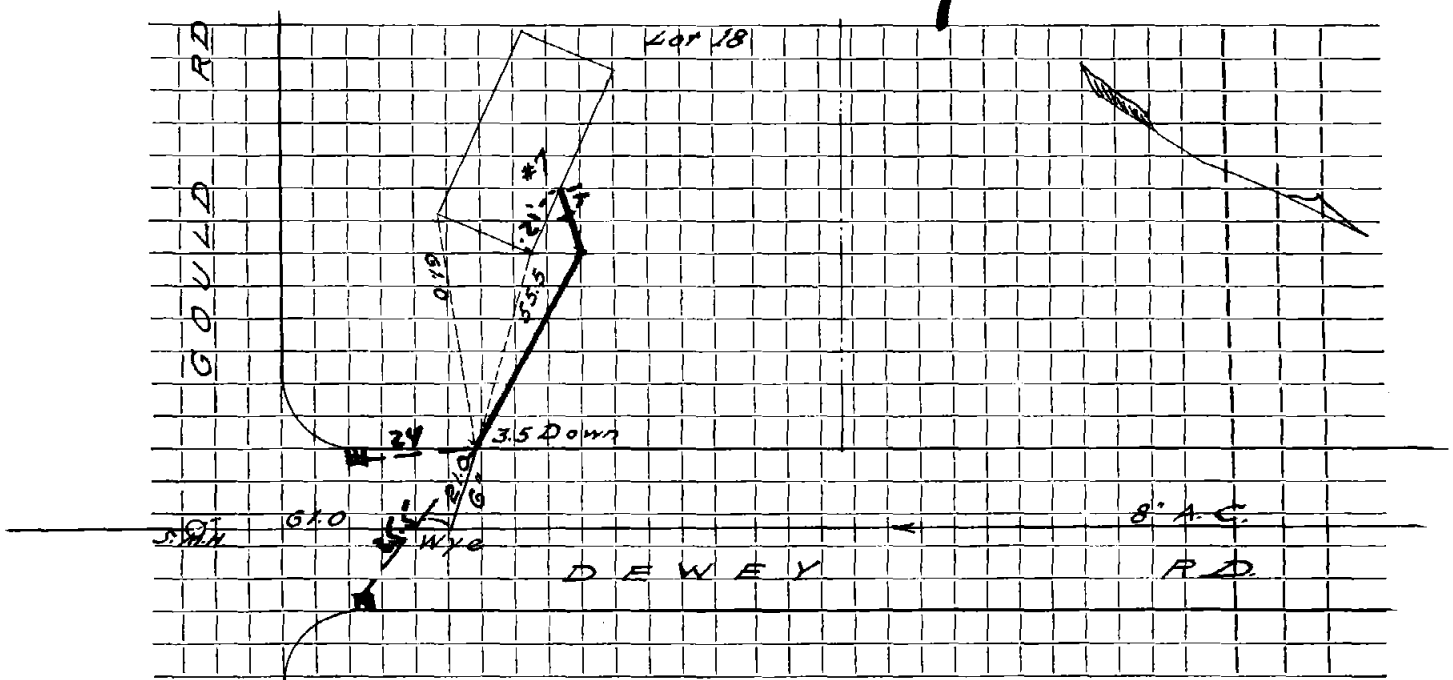

Connection made in ..... Street. Work completed .....

Remarks: .....

.....

.....