[redacted]

Name Reed K. Taylor **Service No.** 19

Address 5 Diana Lane

Lot #3 **Location**

Kind of Pipe **Size** **Size of Main**

Repair—Renewal——New Service 4/22/71 Valeri #1834 **Location** JUL 26 1971

Date		Material	Amount	Total	Date			Amount
~~Nov. '69~~	~~17'~~	~~6" Transite pipe~~	@9.00	153.00	4-20-71		Deposit	153.00
4/22/71	39'	6" Transite pipe						
					11-	- 69		
						17'	6" Transite	

B.M.18501

DATE _____

TOWN OF LEXINGTON — BOARD OF PUBLIC WORKS

SEWER DIVISION

Sketch of Service Here 5

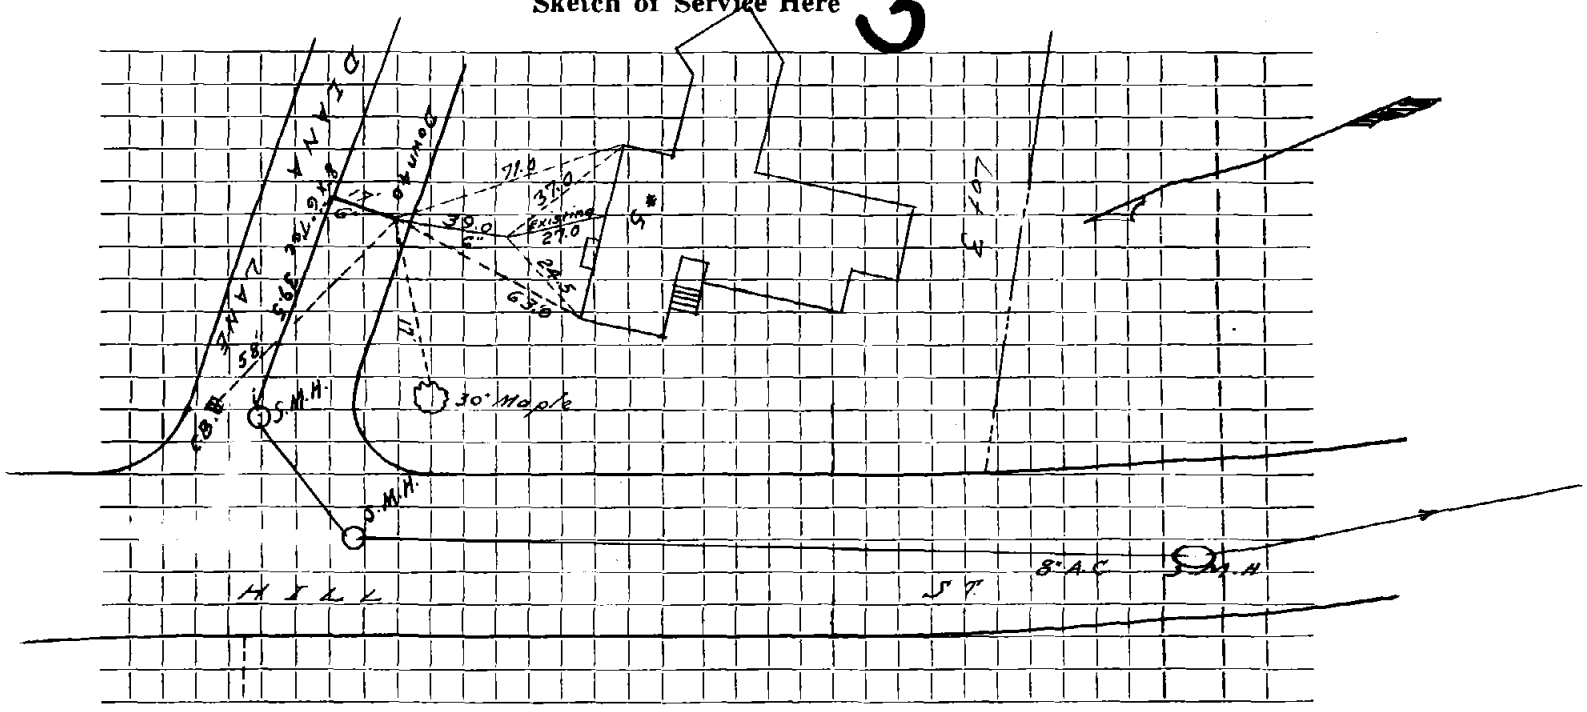

Connection made in ..... Street. Work completed .....

Remarks: .....

.....

.....