Name E. Francis Way **Service No.** 125

Address 20 Douglas Road

Location Lot 37

Kind of Pipe **Size** **Size of Main**

Repair—Renewal—New Service Valeri #1775 **Location** DEC 31 1970

Date		Material	Amount	Total	Date			Amount
~~Nov/1970~~	~~25'~~	~~- 6" Transite pipe~~ @	7.50	$187.50	11-9-70		Deposit	187 50
11/13/70	40'	6" Transite pipe						
	10'	4" Cast Iron pipe						
					11-	-	70	
						25'	6" Transite	

B.M.18501

DATE _____

TOWN OF LEXINGTON — BOARD OF PUBLIC WORKS

SEWER DIVISION

Sketch of Service Here 20

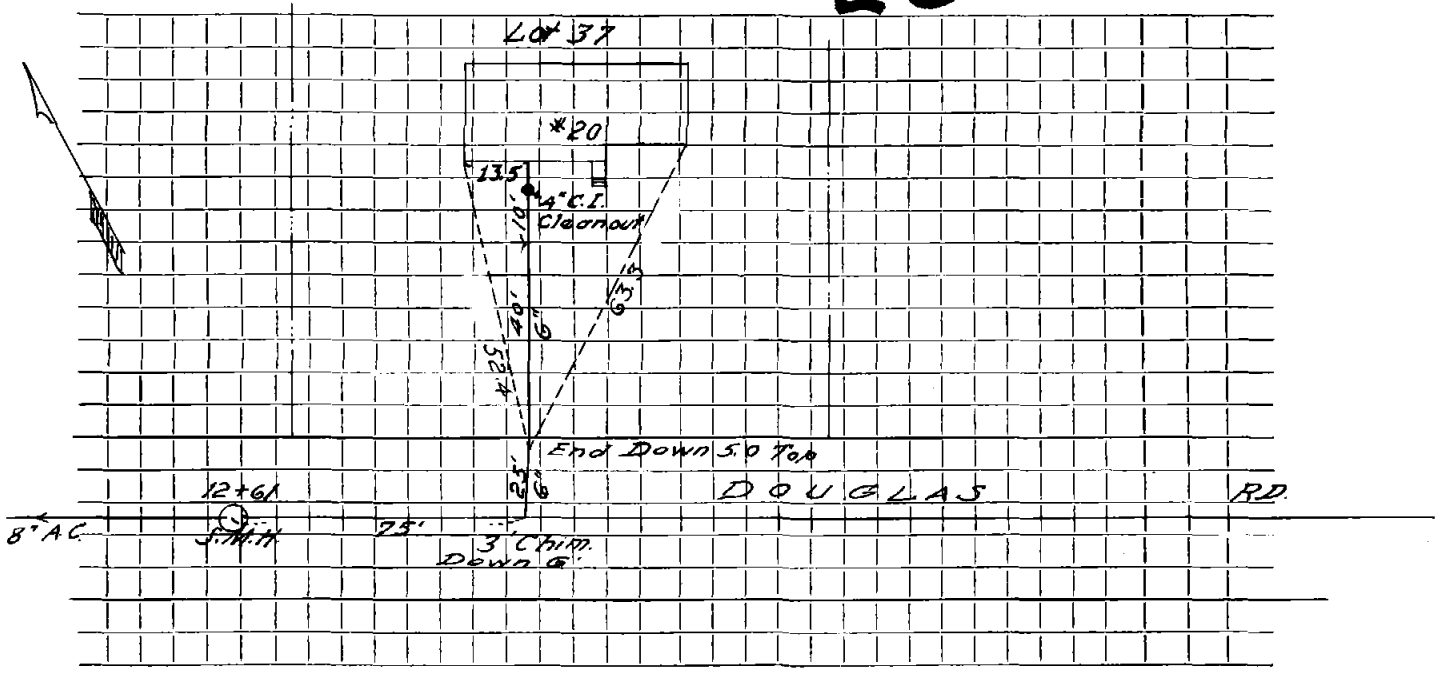

Connection made in ..... Street. Work completed .....

Remarks: .....

.....

.....