Name Elinor Wolfson

Service No. 117

Address 8 Douglas Road

Lot 32

Location

Kind of Pipe

Size

Size of Main

Repair—Renewal——New Service Valeri #1765

Location DEC 31 1970

| Date | | Material | Amount | | Total | | Date | | | Amount | |
|---|---|---|---|---|---|---|---|---|---|---|---|
| ~~Nov'70~~ | ~~29'~~ | ~~6" Transite pipe~~ @ | 7.50 | | 217.50 | | 11-3-70 | | Deposit | 217 | 50 |
| 1/9/70 | 60' | 6" Transite pipe | | | | | | | | | |
| | 10' | 4" Cast Iron Pipe | | | | | 11- | - | 70 | | |
| | | | | | | | | 27' | 6" Transite | | |

B.N.18501

DATE _____

TOWN OF LEXINGTON — BOARD OF PUBLIC WORKS

## SEWER DIVISION

Sketch of Service Here 8

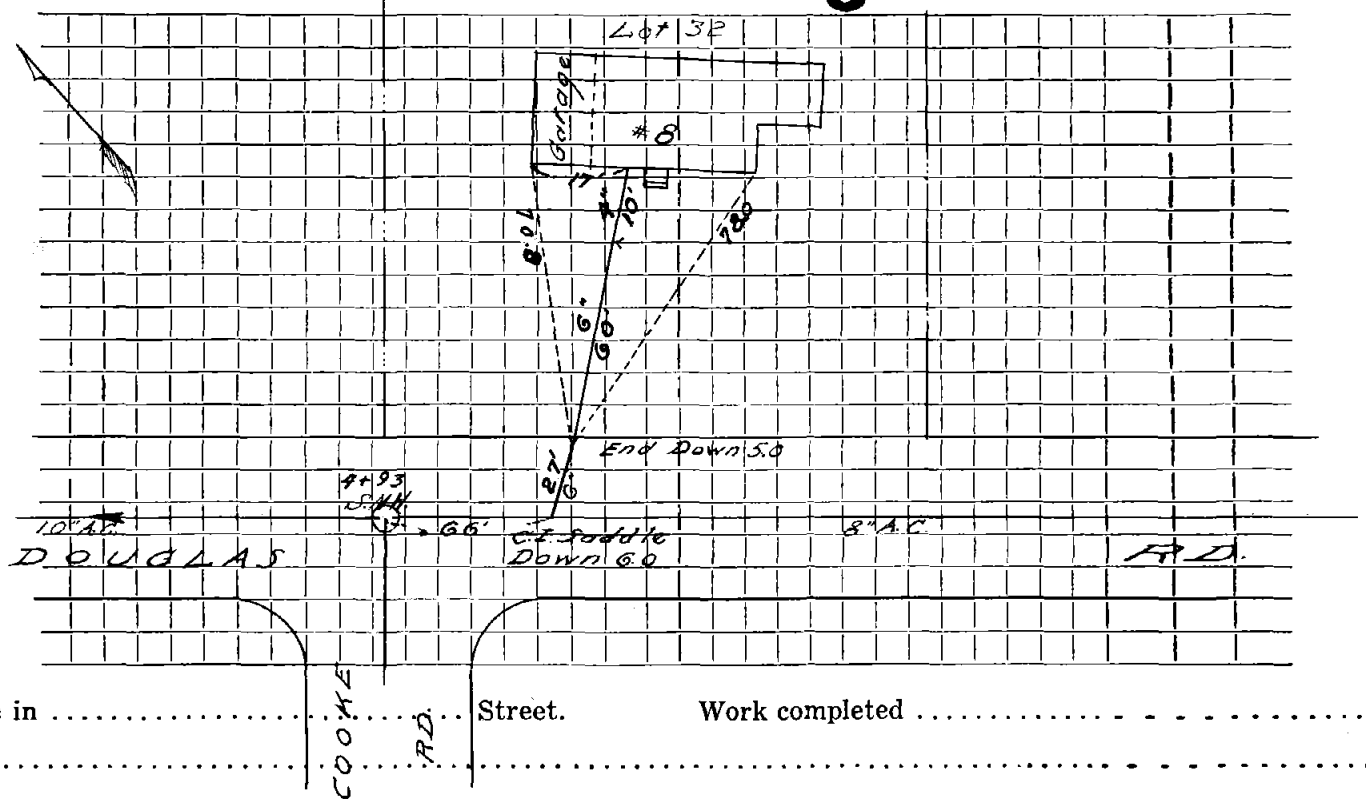


Connection made in ..... Street. Work completed .....

Remarks: .....

.....

.....