Name Duffy Bros. **Service No.**

Address 12 Dudley Road

Lot 215 **Location**

Kind of Pipe **Size** **Size of Main**

Repair—Renewal——New Service Bonanno #1396 & 1493 **Location**

Date		Material	Amount	Total	Date			Amount
	~~24'~~	~~6" Transite pipe~~						
0-17-69	35'	6" Transite pipe						
	10'	4" Cast Iron pipe			10-	-69		
						24'	6" Transite	

.B.M.18501

DATE _____

TOWN OF LEXINGTON — BOARD OF PUBLIC WORKS

SEWER DIVISION

Sketch of Service Here 12

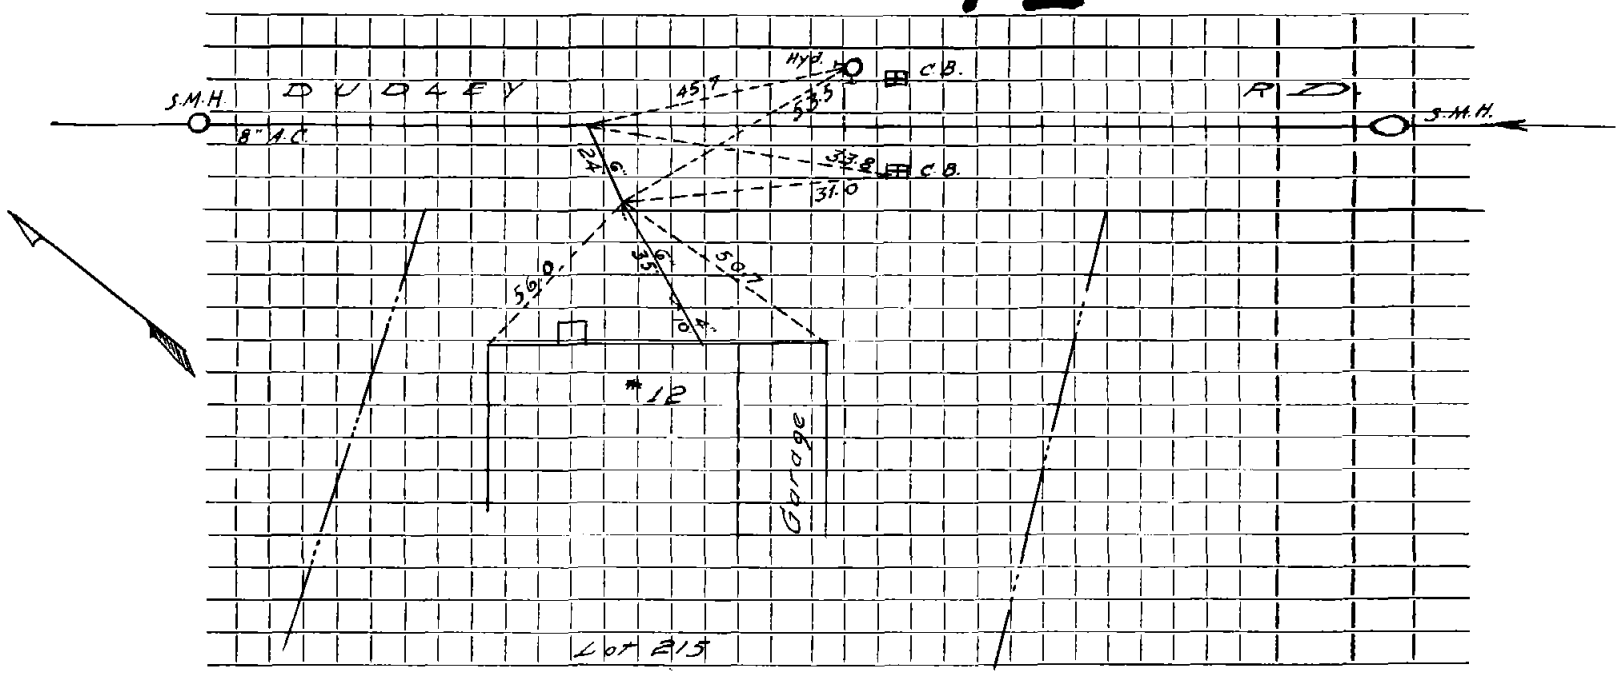

Connection made in ..... Street. Work completed .....

Remarks: .....

.....

.....