Name Duffy Brothers **Service No.**

Address 8 Dudley Road

Lot #217 **Location**

Kind of Pipe **Size** **Size of Main**

Repair—Renewal——New Service Bonanno #1393 &1491 **Location**

Date		Material	Amount	Total	Date			Amount
	~~35'~~	~~6" Transite pipe~~						
1-12-69	30'	6" Transite pipe						
	10'	4" Cast Iron pipe			11-	-69		
						35'	6" Transite	

B.M.18501

DATE _____

TOWN OF LEXINGTON — BOARD OF PUBLIC WORKS

SEWER DIVISION

Sketch of Service Here 8

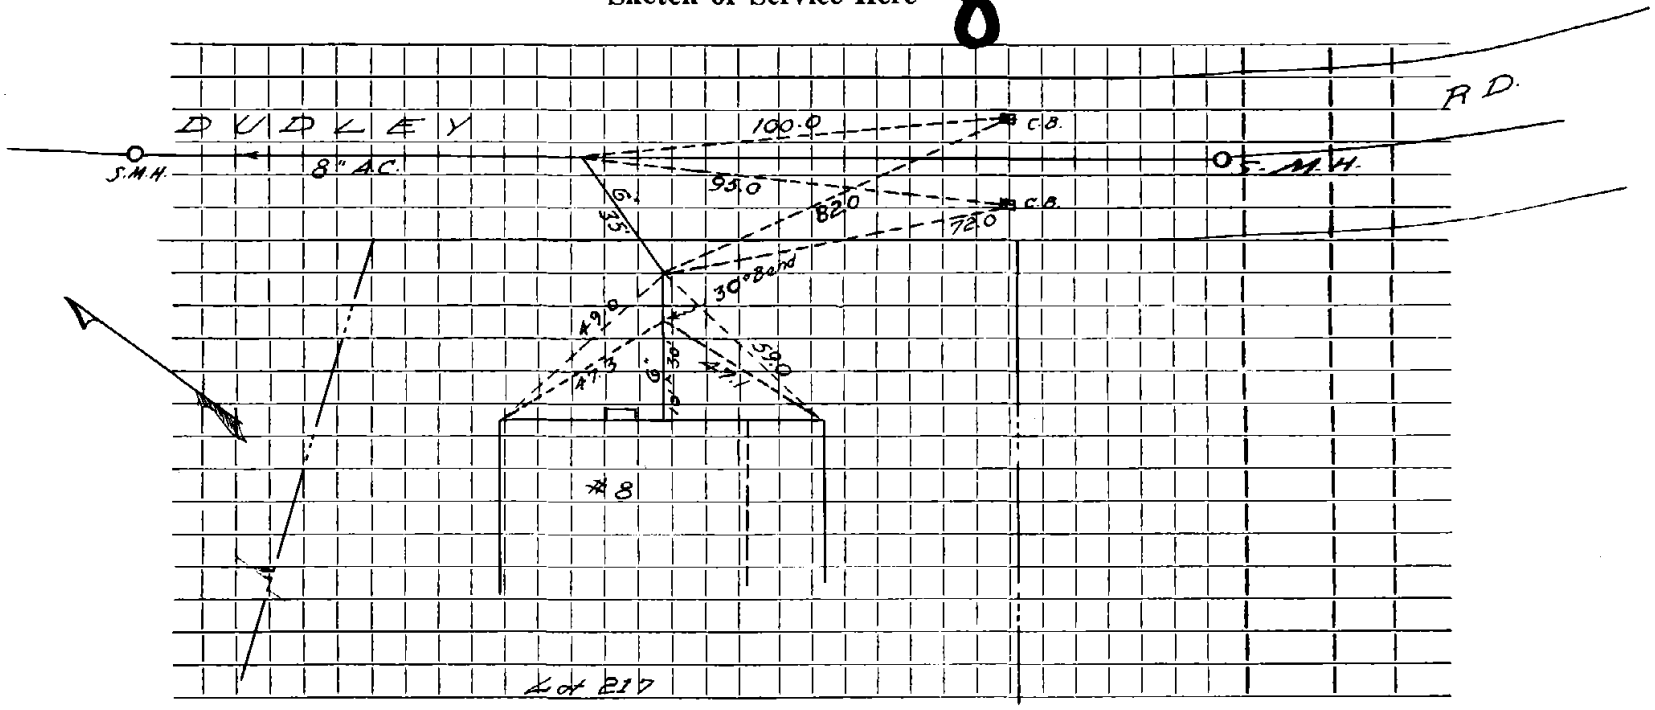

Connection made in ..... Street. Work completed .....

Remarks: .....

.....

.....