Name Edna Korman **Service No.**

Address 121 East Emerson Road

Location

Kind of Pipe **Size** **Size of Main**

~~Repair - Renewal -~~ **New Service** Arlex #3981 **Location**

Date		Material	Amount		Total		Date			Amount	
6/20/85	68'	6" PVC									
	3'	4" Cast Iron									
		6" - Wye Clean Out						'84'			
		4" x 6" Fernco - 1' Deep						37.6'	6" P.V.C.		
	1	6" 45° Bend									

DATE _____

TOWN OF LEXINGTON — BOARD OF PUBLIC WORKS

SEWER DIVISION

Sketch of Service Here 121

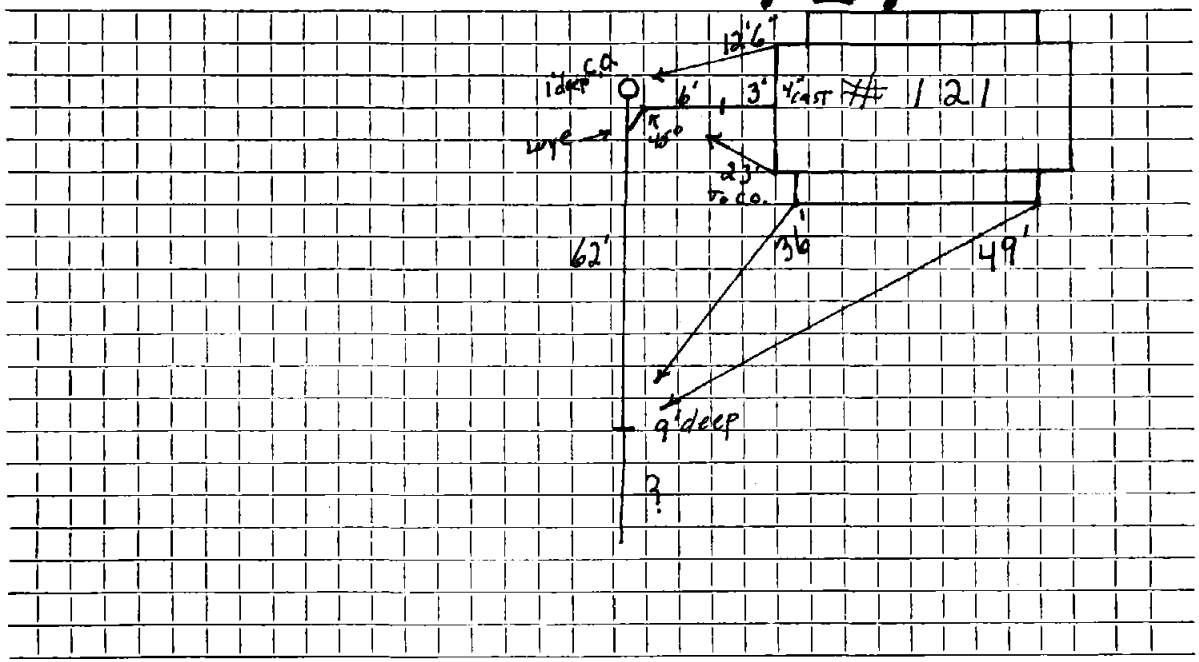

Connection made in ..... Street. Work completed .....

Remarks: .....

.....

.....