Name *Prescott Village Realty Trust* **Service No.**

Address # 177 EAST EMERSON RD

Location

Kind of Pipe PVC **Size** 6" **Size of Main** 8" PVC

~~**Repair**~~—~~**Renewal**~~—**New Service** *Eagle #3803* **Location**

Date		Material	Amount		Total		Date			Amount	
7/12/83	40"	x 6" P.V.C.									
	10'	x 4" C.I.P.									
	1	22½° Elbow									

DATE July 1983

TOWN OF LEXINGTON — BOARD OF PUBLIC WORKS

SEWER DIVISION

Sketch of Service Here 177

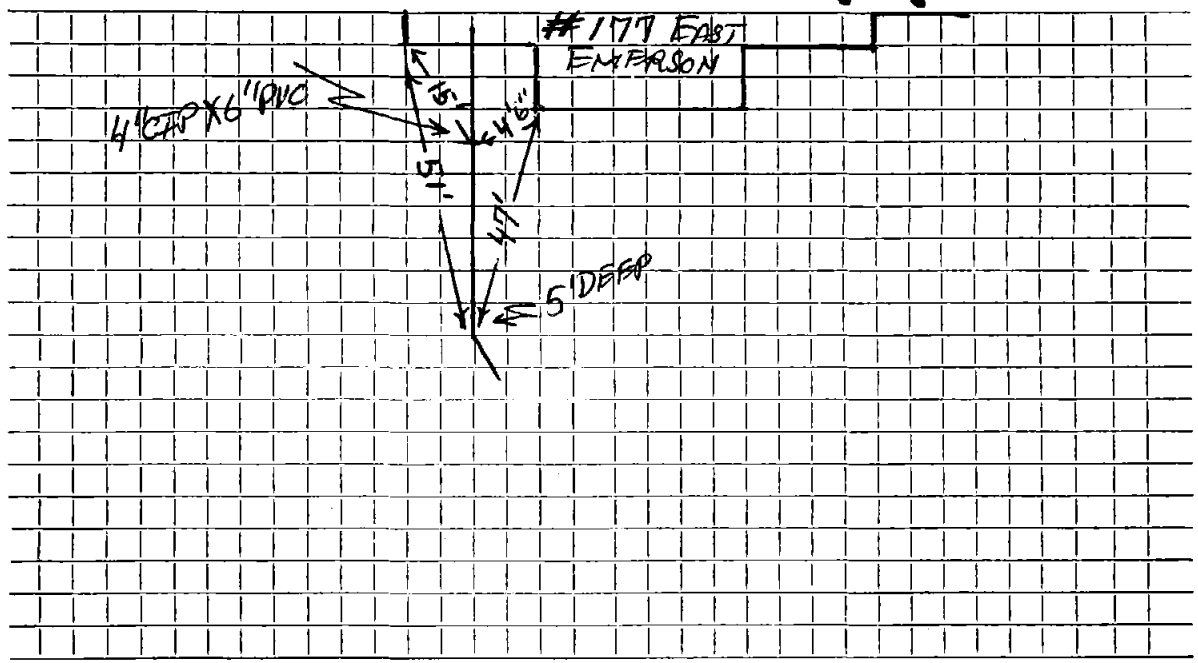

Connection made in EAST EMERSON RD. Street. Work completed July 12, 1983

Remarks: NO OUTSIDE INFORMATION