Name Prescott Village Realty Trust **Service No.**

Address 199 East Emerson Road

Location

Kind of Pipe **Size** **Size of Main**

~~Repair~~ ~~Renewal~~ **New Service** Eagle #4475 **Location**

Date		Material	Amount		Total		Date			Amount	
6/28/84	39'	6" PVC									
	7'	4" PVC									
	1	22° Bend									
	1	4" x 6" Donut									

DATE _____

TOWN OF LEXINGTON — BOARD OF PUBLIC WORKS

SEWER DIVISION

Sketch of Service Here 199

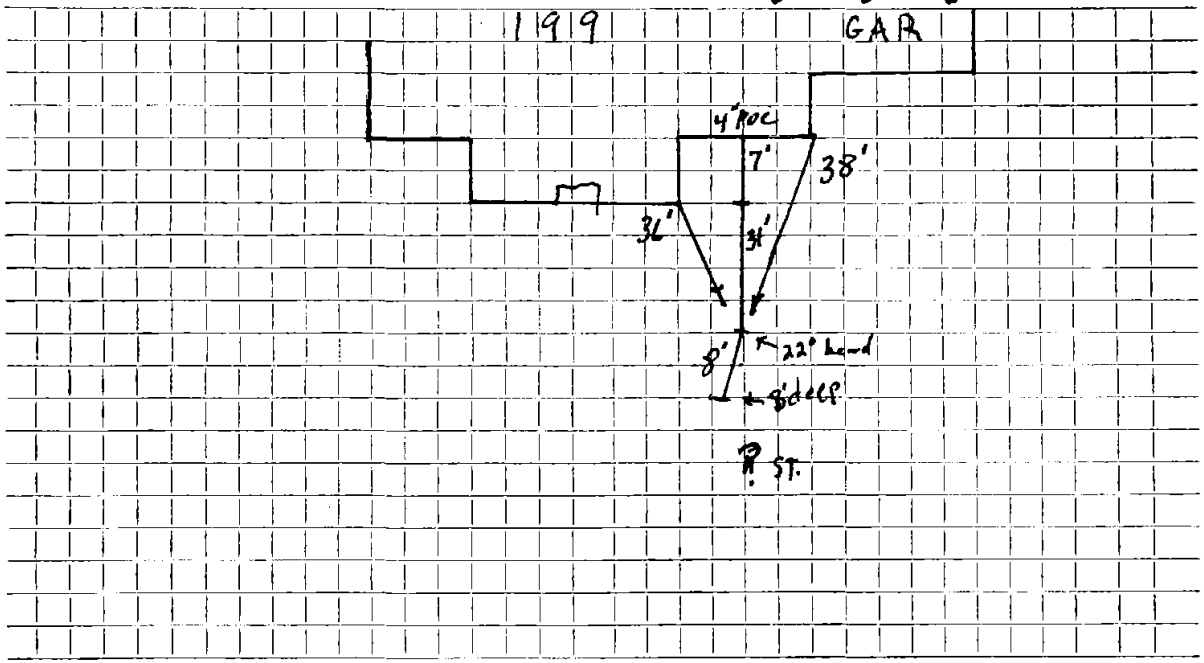

Connection made in ..... Street. Work completed .....

Remarks: .....

.....

.....