Name C. J. Eliades **Service No.** 103

Address # 176 East ST.

Location

Kind of Pipe **Size** 6" A.C. **Size of Main** 8" A.C.

Repair—Renewal—New Service **Location** APR 8 1974

Date		Material	Amount	Total	Date			Amount
~~4/10/72~~		~~31 L.F. @ $9.00~~	$279.00		9-24-73		Deposit	379 00
10/10/73	40'	6" Transite						
	10'	4" Cast Iron			11-10-	72		
						31'	6" A. C.	

F.B.K.18501

DATE _____

TOWN OF LEXINGTON — BOARD OF PUBLIC WORKS

SEWER DIVISION

Sketch of Service Here 175

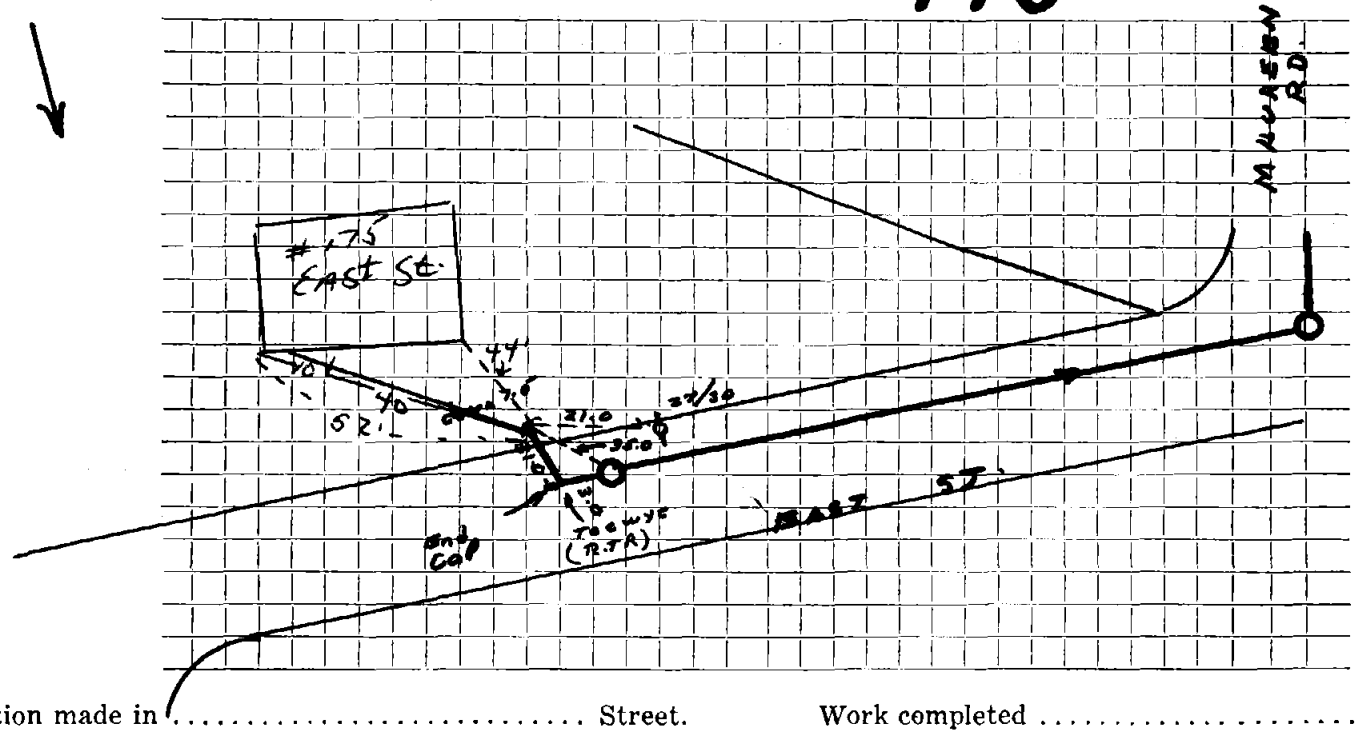

Connection made in ..... Street. Work completed .....

Remarks: .....

.....

.....