Name Mrs. William McLatchy **Service No.** 27

Address #197 EAST 57.

Location JUL 24 1978

Kind of Pipe **Size** 6"A.C. **Size of Main** 8"A.C.

~~Repair—Renewal—~~ **New Service** Eagle #3069 **Location**

Date		Material	Amount	Total	Date			Amount
12/13/72		10.0 A.C. @ 9.00	$90.00		6-14-78		Deposit	90.00
6/23/78	57'	6" Transite Pipe						
	10'	4" Cast Iron Pipe						
					12-13-72			
						10'	6" A.C.	

H.B.M.18501

DATE _____

TOWN OF LEXINGTON — BOARD OF PUBLIC WORKS

SEWER DIVISION

Sketch of Service Here 197

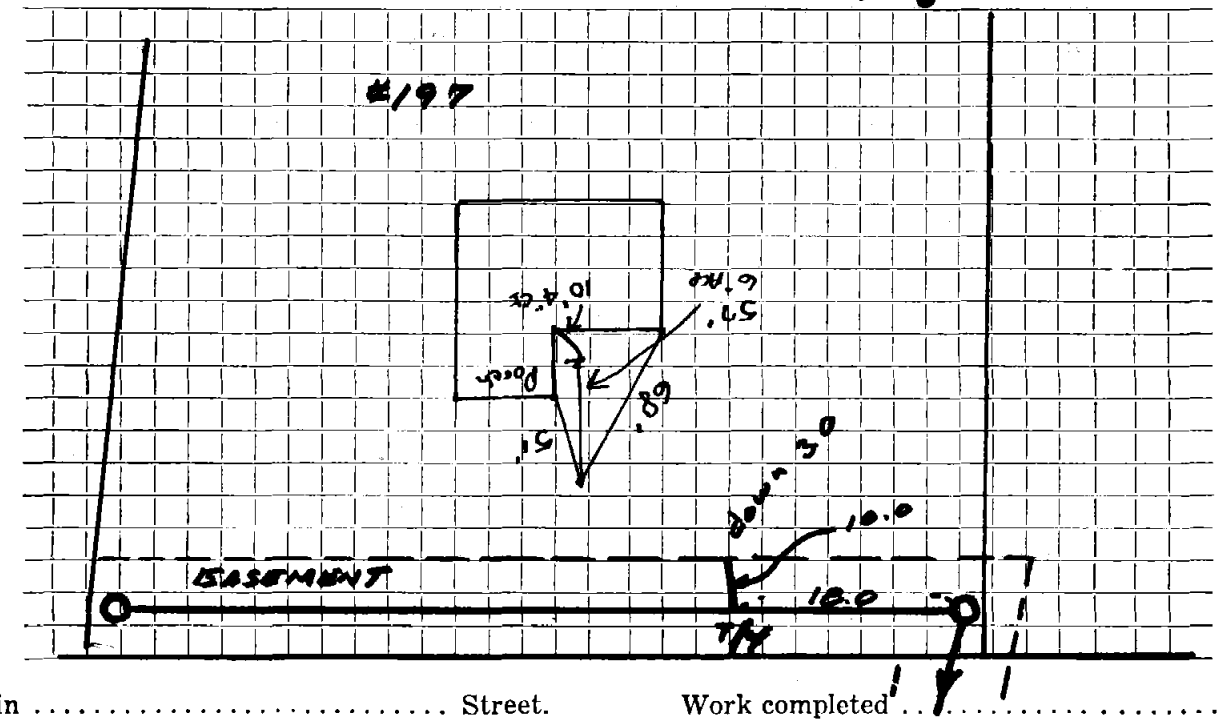

Connection made in ..... Street. Work completed .....

Remarks: .....

.....

.....