Name R. J. Foley Realty **Service No.**

Address 15 Elena Road

Location

Kind of Pipe **Size** **Size of Main**

Repair—Renewal——New Service DeFlice Bros. #549 **Location**

Date		Material	Amount		Total		Date			Amount	
/15/67	106'	6" Transite pipe									
	10'	4" Cast Iron pipe									

M.18501

DATE _____

TOWN OF LEXINGTON — BOARD OF PUBLIC WORKS

SEWER DIVISION

Sketch of Service Here 15

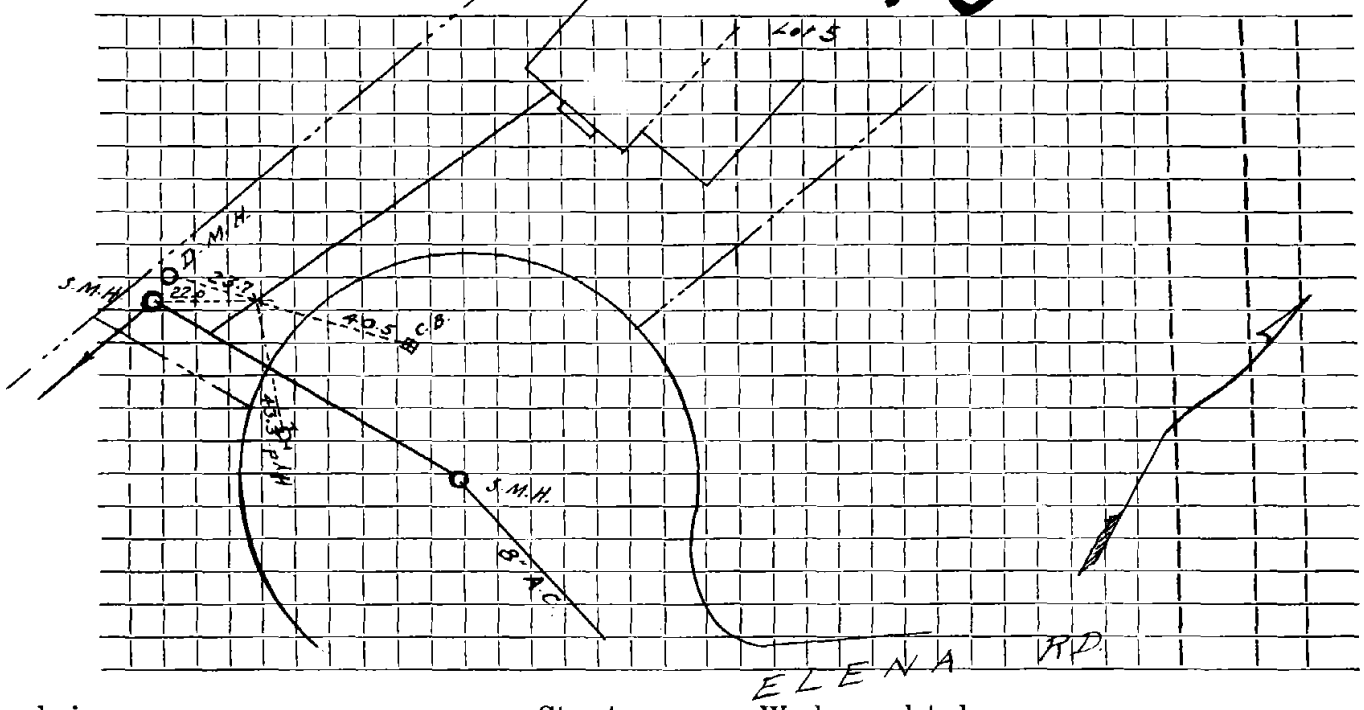

Connection made in ..... Street. Work completed .....

Remarks: .....

.....

.....