Name R. J. Foley Realty **Service No.**

Address 4 Elena Road

Location

Kind of Pipe **Size** **Size of Main**

Repair—Renewal——New Service DeFlice Bros. #548 **Location**

Date		Material	Amount	Total	Date		Amount
/27/67	42'	6" Transite Pipe					
	10'	4" Cast Iron Pipe					

B.M.18501

DATE _____

TOWN OF LEXINGTON — BOARD OF PUBLIC WORKS

SEWER DIVISION

Sketch of Service Here **4**

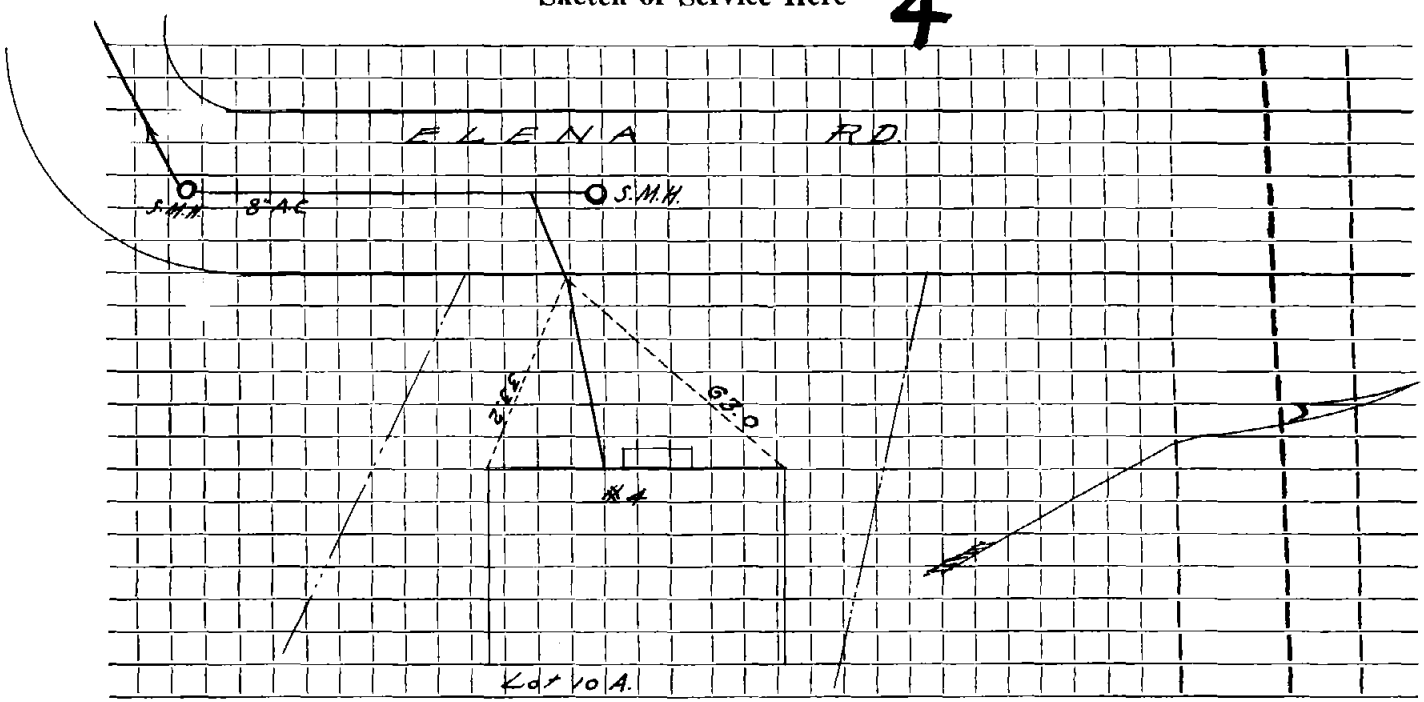

Connection made in ..... Street. Work completed .....

Remarks: .....

.....

.....