[redacted]

Name Ivan K. Hoyt **Service No.**

Address 11 Eliot Road

Location

Kind of Pipe **Size** **Size of Main**

~~Repair~~—Renewal—~~New Service~~ Arlex 4126 **Location**

Date		Material	Amount		Total		Date			Amount	
5/24/85	25'	6" PVC									
	1	PVC x VCP Fernco									
	1	6" x 4" Donut									
									OUTSIDE		
							4/5/30	19'	x 6" VCP		

DATE MAY 24, 1985

TOWN OF LEXINGTON — BOARD OF PUBLIC WORKS

SEWER DIVISION

Sketch of Service Here

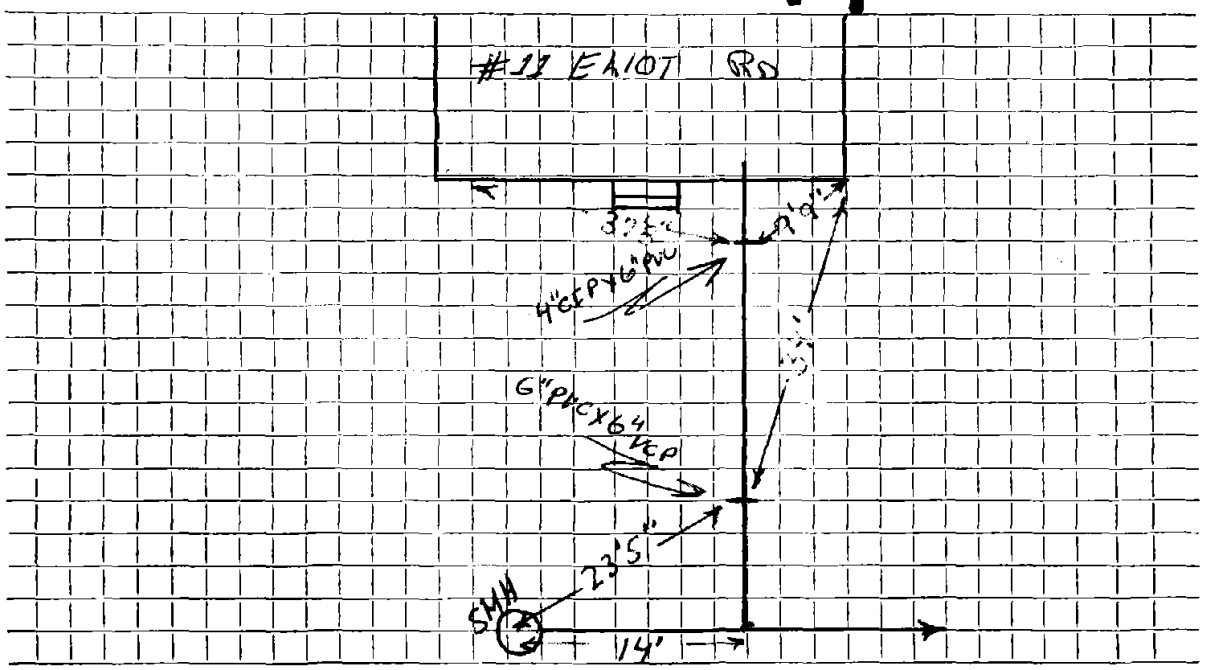

Connection made in ELIOT ROAD ..... Street. Work completed .....

Remarks: 45' X 6" V.C. PIPE INSTALLED 4/5/30

NOTE: WATER & SEWER IN SAME TRENCH - CURB BOX DIRECTLY ON TOP OF SEWER PIPE