Name Ralph F. Johnson **Service No.** 82

Address 16 Emerald Street

Location

Kind of Pipe **Size** **Size of Main** 8"

X ~~Repair~~ ~~Remark~~ **New Service** Griecci #3039 **Location** Comm. 2-13-78

Date		Material	Amount		Total		Date			Amount	
~~7/21/77~~	~~21'~~	~~6" Transite Pipe~~ @	$10.00		210.	00	9-19-77		Deposit	210	00
		Redmond #4265									
9/2/86	60'	6" PVC									
	10'	4" PVC					7-21-77				
	1	6" Fernco						21'	6" Transite		
	1	6" 22° Bend									
	1	AC to PVC Adpt.									
	1	4" x 6" Fernco									

DATE _____

TOWN OF LEXINGTON — BOARD OF PUBLIC WORKS

SEWER DIVISION

Sketch of Service Here 16

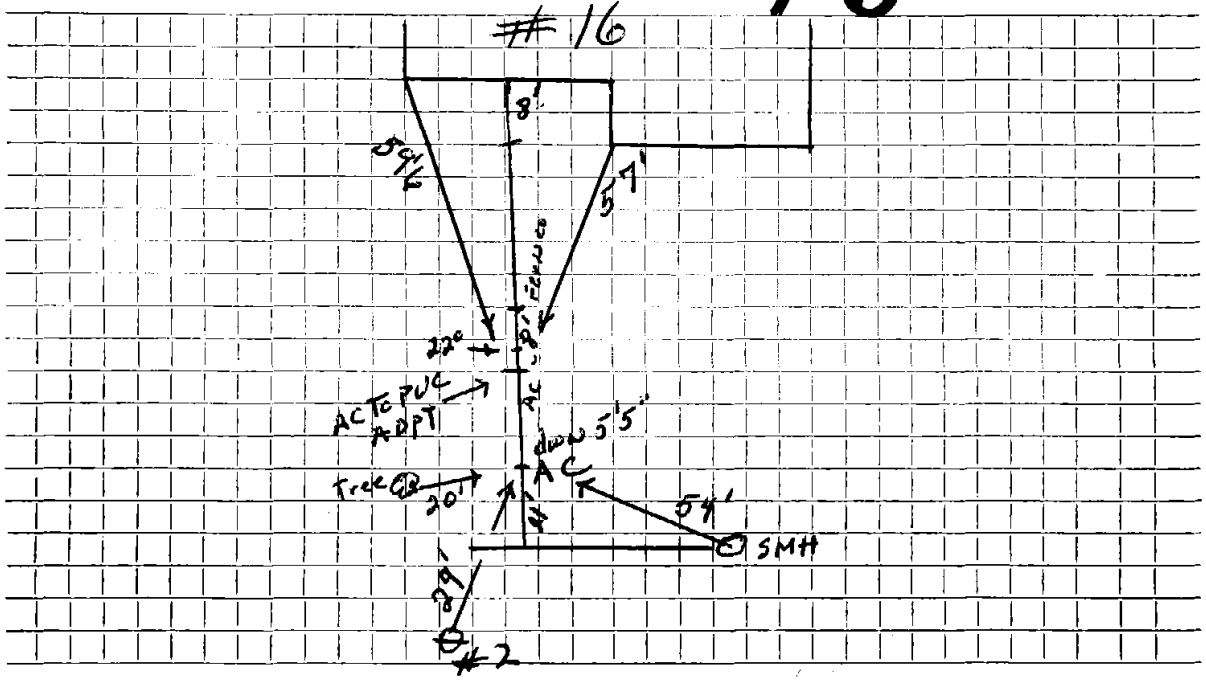

Connection made in ..... Street. Work completed .....

Remarks: Tied on to AC Pipe on Prop.