[redacted]

**Name** Barry Ginsburg **Service No.**

**Address** 2 EWELL AVE.

**Location**

**Kind of Pipe** CI & TRANSITE **Size** 4"x6" **Size of Main**

**Repair—Renewal—New Service** McKee 0597 **Location**

| Date | Material | Amount | Total | Date | | Amount |
|---|---|---|---|---|---|---|
| 9-30-91 | 21.6 LF 4" CI | | | | | |
| | 6" 22° ELBOW | | | | | |
| | 4"x6" FERNCO | | | 7-13- | 54 | |
| | 6"x6" FERNCO | | | | 36' 6" Sewer Pipe | |
| | | | | | 1 6"- 1/4° Bend | |
| | | | | 9-23- | 91 Pipe Collapsed | |

DATE '91

TOWN OF LEXINGTON — BOARD OF PUBLIC WORKS

SEWER DIVISION

# 2 Fiwell Ave

Sketch of Service Here 2

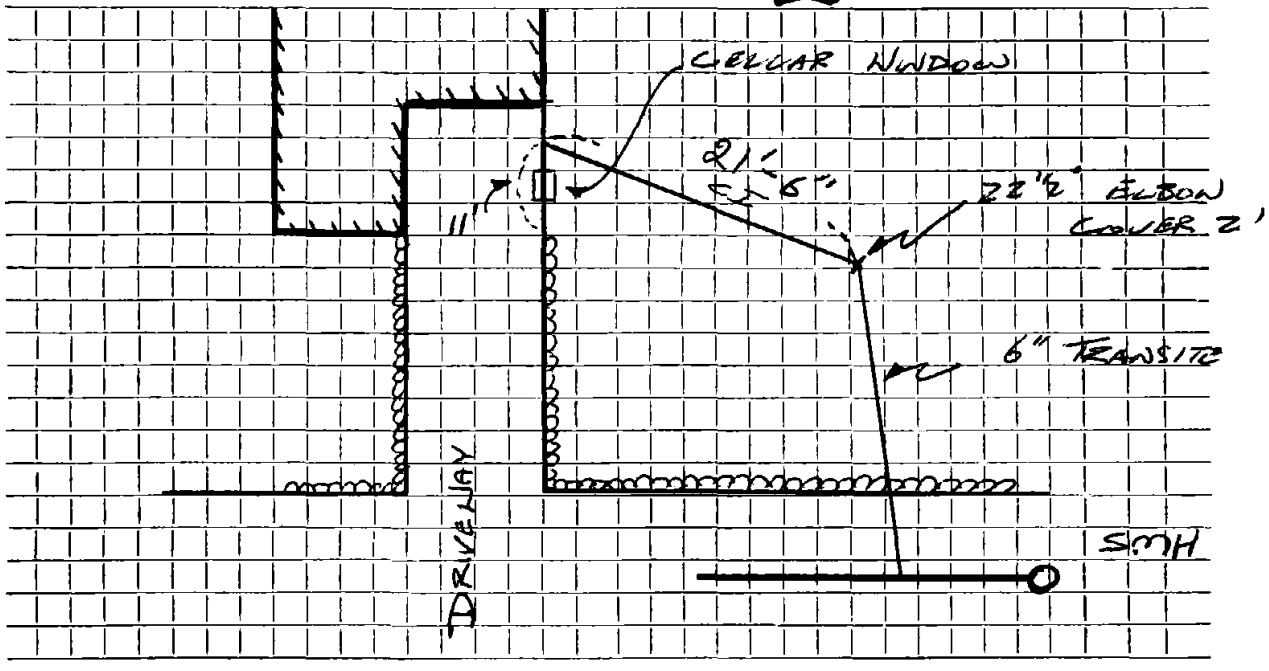


Connection made in ..... Street. Work completed .....

Remarks: .....

.....

.....