[redacted]

Name Arthur Sweet **Service No.**

Address 33 EWELL AVE.

Location

Kind of Pipe PVC **Size** 31 LF 6" **Size of Main**

Repair—Renewal—New Service E.Banks 0622 **Location**

Date		Material	Amount		Total		Date			Amount	
6/26	92	3.5 LF 4" C.I.									
		31 LF 6" PVC									
		4"X6" FERNCO						1953			
		6"X6" FERNCO						52'			
							3-29-	92	Roots + Solids 29' out		

DATE 6/20/92

TOWN OF LEXINGTON — BOARD OF PUBLIC WORKS

SEWER DIVISION

Sketch of Service Here **33**

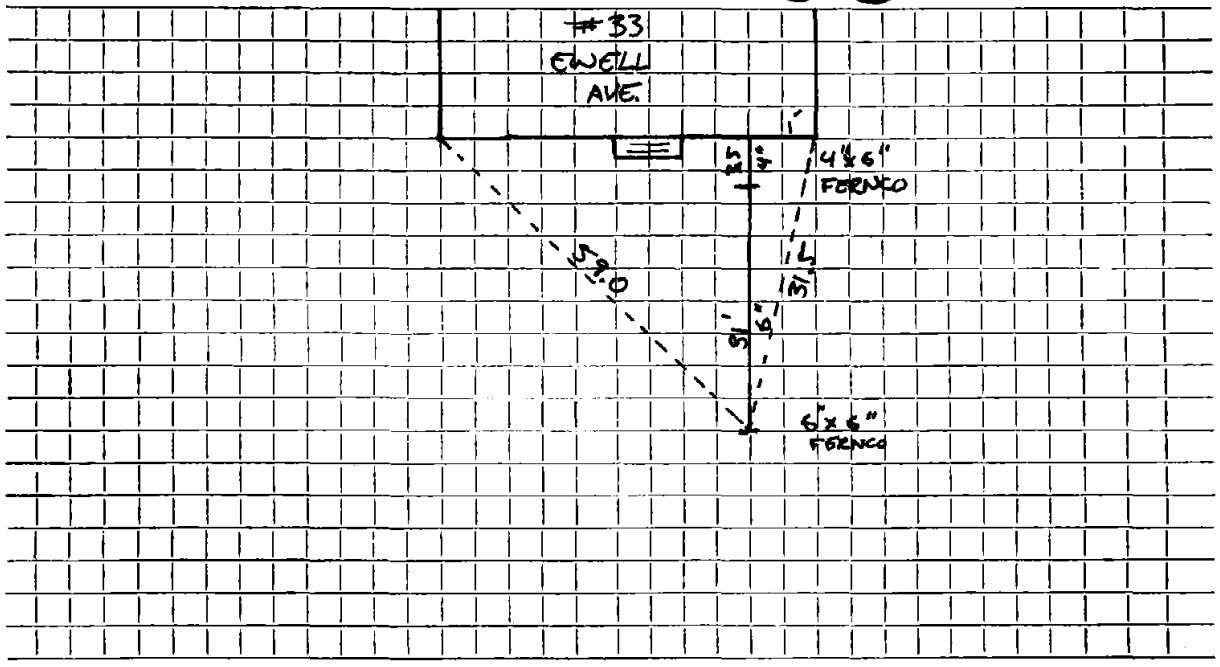

Connection made in ..... Street. Work completed .....

Remarks: Installed By E.R. Banks

Inspected By CRG