Name **Service No.**

Address 44 FAIROAKS DR.

Location

Kind of Pipe **Size** **Size of Main**

Repair—Renewal—New Service **Location**

Date	Material	Amount	Total	Date		Amount
8/14/89	7 LF 4" CI					
	121.6 LF 6" PVC					
	2 - 4"x6" WYE CLEANOUTS					
	2 - 4"x6" WYES					
	6" - 22° SWEEP					
	6" - 22° ELBOW					
	6" - FERNCO					

DATE _____

TOWN OF LEXINGTON — BOARD OF PUBLIC WORKS

SEWER DIVISION

Sketch of Service Here **44**

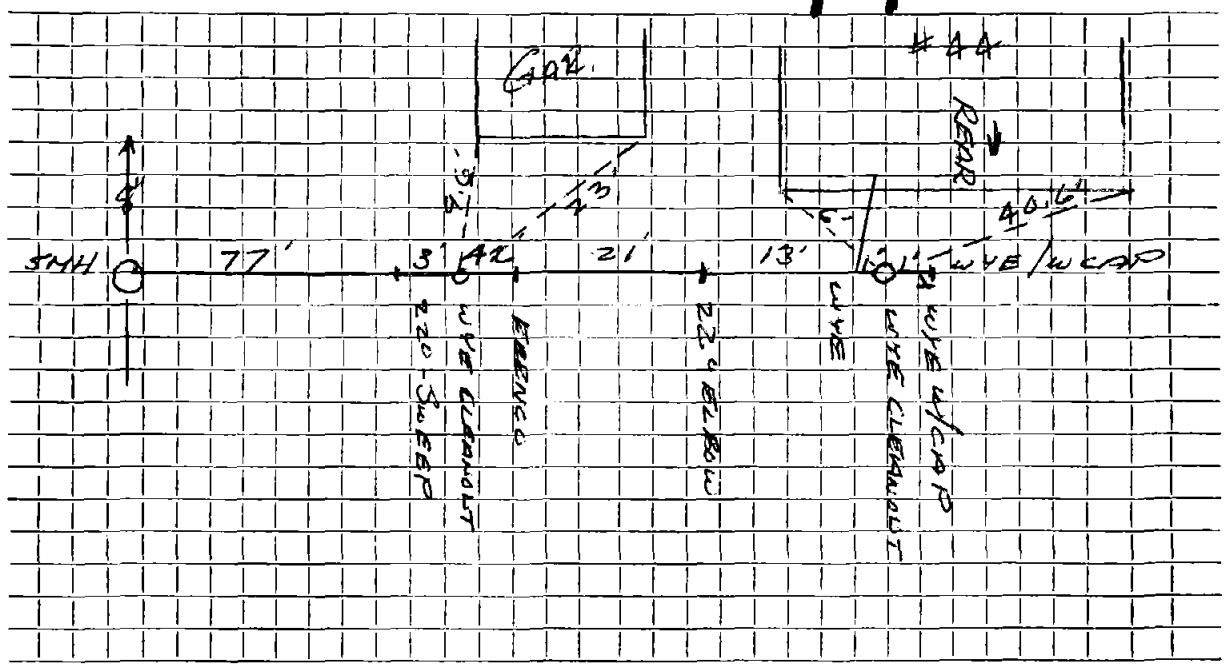

Connection made in FAIROAKS DR. Street. Work completed .....

Remarks: SERVICE IN REAR