[redacted]

Name Oak Park Corp. **Service No.**

Address 6 Fairfield Drive

Location

Kind of Pipe **Size** **Size of Main**

Repair—Renewal——New Service Lucente #2046 Lucente #1589 **Location**

Date		Material	Amount		Total		Date			Amount	
~~5-13-70~~	~~30'~~	~~6" Transite pipe~~									
5-2-72	28'	6" Transite pipe									
	10'	4" Cast Iron pipe					5-13-	70			
								30'	6" Transite		

.B.M.18501

DATE _____

TOWN OF LEXINGTON — BOARD OF PUBLIC WORKS

SEWER DIVISION

Sketch of Service Here 6

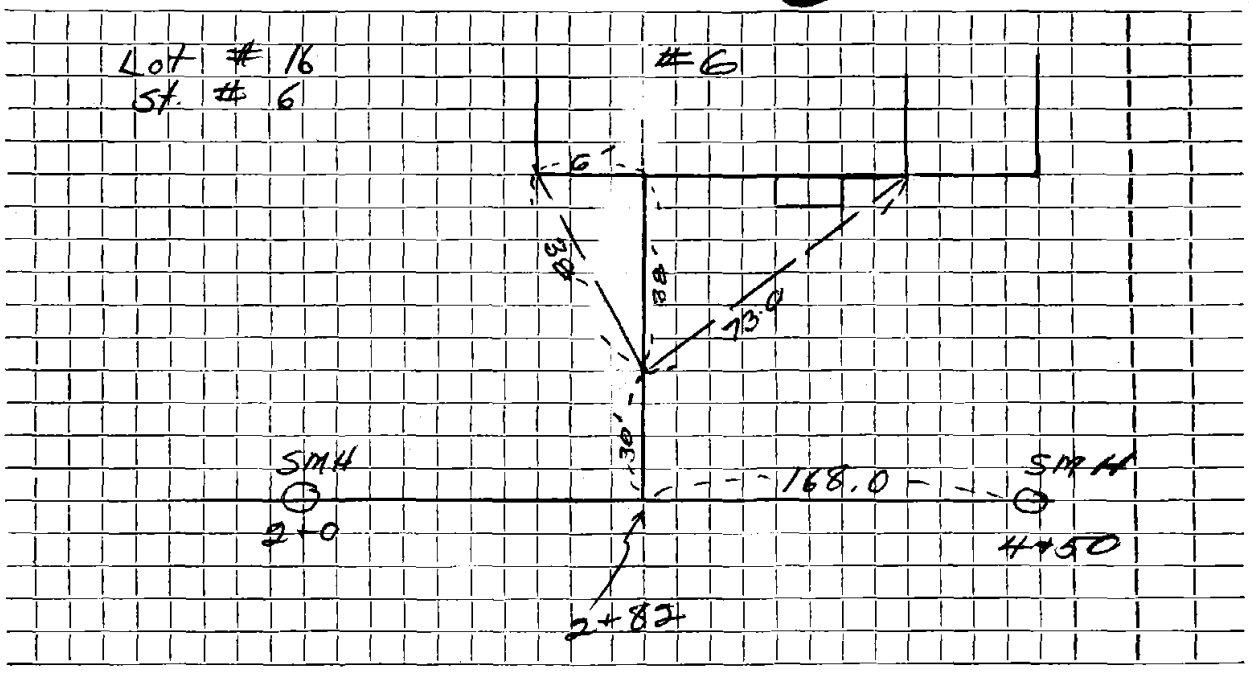

Connection made in ..... Street. Work completed .....

Remarks: .....

.....

.....